


15-065-00578-00-10

STATE OF KANSAS
STATE CORPORATION COMMISSION

WELL PLUGGING RECORD

Give All Information Completely
Make Required Affidavit
Mail or Deliver Report to:
Conservation Division
State Corporation Commission
211 No. Broadway
Wichita, Kansas

Graham County. Sec. 36 Twp. 9 Rge. 22W (E) (W)
Location as "NE/CNW/SW" or footage from lines NE NE SE
Lease Owner D. G. Hansen
Lease Name R. C. Holmes Well No. 1
Office Address Logan, Kansas
Character of Well (completed as Oil, Gas or Dry Hole) Dry Hole
Date well completed January 24 1958
Application for plugging filed January 24 1958
Application for plugging approved January 24 1958
Plugging commenced January 24 1958
Plugging completed January 24 1958
Reason for abandonment of well or producing formation Too low structually

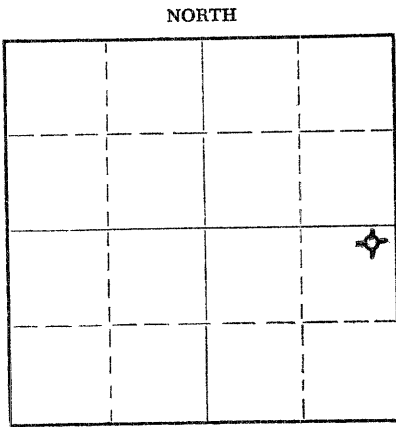

Locate well correctly on above
Section Plat

Name of Conservation Agent who supervised plugging of this well Eldon Petty, Hays, Kansas
Producing formation _____ Depth to top _____ Bottom _____ Total Depth of Well 3980 Feet
Show depth and thickness of all water, oil and gas formations.

OIL, GAS OR WATER RECORDS

CASING RECORD

FORMATION	CONTENT	FROM	TO	SIZE	PUT IN	PULLED OUT
				8-5/8"	171.72'	none

Describe in detail the manner in which the well was plugged, indicating where the mud fluid was placed and the method or methods used in introducing it into the hole. If cement or other plugs were used, state the character of same and depth placed, from _____ feet to _____ feet for each plug set.

Filled hole with heavy mud to 500'. Set plug. Put in 25 sacks cement. Filled to 180'. Set plug. Put in 15 sacks cement. Filled with heavy mud up to 40'. Set plug. Filled to top with 1/2 sack hulls and 10 sacks cement.

RECEIVED
STATE CORPORATION COMMISSION
FEB 3 1958
2-3-58
CONSERVATION DIVISION
Wichita, Kansas

(If additional description is necessary, use BACK of this sheet)

Name of Plugging Contractor C-G Drilling Co.
Address 107 Rule Building, Wichita, Kansas

STATE OF KANSAS, COUNTY OF SEDGWICK, ss.
Jay H. Galloway (employee of owner) or (owner or operator) of the above-described well, being first duly sworn on oath, says: That I have knowledge of the facts, statements, and matters herein contained and the log of the above-described well as filed and that the same are true and correct. So help me God.

(Signature) Jay H. Galloway
107 Rule Building
(Address)

SUBSCRIBED AND SWORN TO before me this 27th day of January, 1958

My commission expires May 20, 1959
Vicky Jacobs Notary Public.

PLUGGING
SEC 36 T 9 R 22W
PAGE 79 LINE 9

CONTRACTOR'S WELL LOG

OPERATOR D. G. Hansen WELL NAME R. C. Holmes #1
 LOCATION NE NE SE SEC. 36-9-22W RIG NO. 1
 COUNTY Graham STATE Kansas
 COMMENCEMENT DATE January 16, 1958 COMPLETION DATE January 24, 1958

LOG OF WELL

Elevation 2329' rotary bushing.
 All measurements taken from the top of rotary bushing.

FROM	TO	FORMATION	DEVIATION FROM VERTICAL	REMARKS:
0	171	Sand-Shale		
171	1000	Sand-Shale		
1000	1350	Sand-Shale		
1350	1550	Sand		
1550	1805	Red Bed		
1805	1815	Anhydrite		
1815	1845	Anhydrite		
1845	2200	Shale-Lime		
2200	2455	Lime-Shale		
2455	2620	Shale-Lime	0° - 2500	
2620	2730	Shale-Lime		
2730	2935	Lime-Shale	0° - 2750	
2935	3060	Lime-Shale	0° - 3000	
3060	3200	Lime-Shale		
3200	3350	Lime-Shale	0° - 3250	
3350	3470	Lime-Shale		
3470	3544	Lime-Shale		
3544	3605	Lime-Shale		
3605	3667	Lime		
3667	3717	Lime		
3717	3756	Lime-Shale		
3756	3807	Lime		
3807	3869	Lime		
3869	3898	Lime-Shale		
3898	3953	Lime		
3953	3980	Lime		

CASING LEFT IN HOLE AFTER COMPLETION

Ran 171.72' (9 jts.) 8-5/8" OD Surface Casing.

STATE OF KANSAS }
 COUNTY OF SEDGWICK } SS.

PLUGGING
 FILE SEC. 36 T. 9 R. 224
 BOOK PAGE 79 LINE 9

The undersigned hereby certifies that to the best of his knowledge and belief, the above facts are true and correct.

C-O DRILLING CO.

By Jay H. Galloway
 Jay H. Galloway

SUBSCRIBED AND SWORN TO BEFORE ME THIS 27th day of January, 1958.

Vicky Jacobs
 Vicky Jacobs, Notary Public

My commission expires: May 20, 1959