

STATE OF KANSAS
STATE CORPORATION COMMISSION

Give All Information Completely
Make Required Affidavit
Mail or Deliver Report to:
Conservation Division
State Corporation Commission
211 No. Broadway
Wichita, Kansas

WELL PLUGGING RECORD

Graham County, Sec. 36 Twp. 9 Rge. 22 (W)

Location as "NE/CNW/SW" or footage from lines SW NW SW

Lease Owner Woodman & Iannitti and Brown & Fortier

Lease Name Wolfe Well No. 1

Office Address Box 387, Hoisington, Kansas

Character of Well (completed as Oil, Gas or Dry Hole) Dry Hole

Date well completed 9-14 19 57

Application for plugging filed 9-14 19 57

Application for plugging approved 9-14 19 57


Plugging commenced 9-14 19 57

Plugging completed 9-14 19 57

Reason for abandonment of well or producing formation Dry

If a producing well is abandoned, date of last production 19

Was permission obtained from the Conservation Division or its agents before plugging was commenced? Yes.

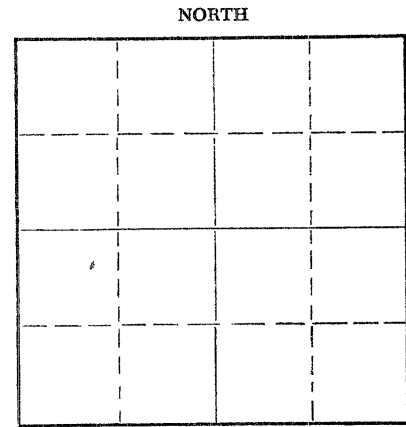

Locate well correctly on above Section Plat

Name of Conservation Agent who supervised plugging of this well Eldon Petty

Producing formation Depth to top Bottom Total Depth of Well 3800 Feet

Show depth and thickness of all water, oil and gas formations.

OIL, GAS OR WATER RECORDS

CASING RECORD

FORMATION	CONTENT	FROM	TO	SIZE	PUT IN	PULLED OUT
				8 5/8"	190'	

Describe in detail the manner in which the well was plugged, indicating where the mud fluid was placed and the method or methods used in introducing it into the hole. If cement or other plugs were used, state the character of same and depth placed, from feet to feet for each plug set.

Filled hole with heavy rotary mud. Bottom plug 600' - 20 sacks cement. Plug 180' - 20 sacks cement. Top plug 40' - 1/3 sack hulls, 10 sacks cement.

(If additional description is necessary, use BACK of this sheet)

Name of Plugging Contractor Woodman & Iannitti Drilling Co.

Address Box 387, Hoisington, Kansas

STATE OF KANSAS, COUNTY OF SEDGWICK, ss.

K. T. Woodman (employee of owner) or (owner or operator) of the above-described well, being first duly sworn on oath, says: That I have knowledge of the facts, statements, and matters herein contained and the log of the above-described well as filed and that the same are true and correct. So help me God.

(Signature) K. T. Woodman

717 Union National Bldg., Wichita 2, Kansas (Address)

SUBSCRIBED AND SWORN TO before me this 14th day of September, 19 57

Mildred E. Lick, Notary Public.

My commission expires March 15, 1961

SEP 15 1957
9-18-57
CONSERVATION DIVISION
Wichita, Kansas

PLUGGING
FILE SEC 36 T. 9 R. 22 W
BOOK PAGE 46 LINE 11

DRILLING LOG

Company: Woodman & Iannitti and Brown & Fortier
Lease: #1 WOLFE SW NW SW (990' from NL and 1800' from SL.
This is a long quarter.)
36-9-22W, Graham County, Kansas
Contractor: Woodman & Iannitti Drilling Company
P. O. Box 387, Holsington, Kansas
Date Commenced: September 6, 1957
Date Completed: September 14, 1957
Total Depth: 3800'
Casing: 8 5/8" at 190' with 125 sacks cement.

Figures Indicate the Bottom of Formation

0-180	Sand & Clay	2810	Lime & Shale
190	Blue Shale	2980	Lime - sandy & Shale
345	Blue Shale	3047	Lime
825	Blue Shale	3200	Shale & Lime
840	Sand	3320	Shale & Lime
1500	Shale & Sand	3400	Lime
1570	Sand	3460	Lime
1815	Shale - Shells - Red Bed	3540	Lime - Shale
1847	Anhydrite	3585	Lime
1900	Shale - Red Bed	3620	Lime
2125	Shale - Shells	3650	Lime
2340	Shale & Lime	3665	Lime
2400	Shale - Shells	3700	Lime
2510	Shale - Lime Sandy	3745	Lime
2530	Lime - Shale	3749	Lime
2660	Lime	3800	Lime

GEOLOGICAL TOPS

Elevation	2333	RB
Anhydrite	1805	7528
Heebner	3523	-1190
Toronto	3540	-1207
Lansing	3559	-1226
Base K.C.	3795	-1462
Total Depth	3800	-1467

I certify the above to be a true and correct copy of the Driller's Log and Geological Tops to the best of my knowledge and belief.

WOODMAN & IANNITTI DRILLING CO.

By: K. T. Woodman
K. T. Woodman

PLUGGING
FILE SEC 36 T 9 R 22W
BOOK PAGE 46 LINE 11