


STATE OF KANSAS
STATE CORPORATION COMMISSION

Give All Information Completely
Make Required Affidavit
Mail or Deliver Report to:
Conservation Division
State Corporation Commission
800 Biting Building
Wichita, Kansas

WELL PLUGGING RECORD

Graham County. Sec. 36 Twp. 9 Rge. (E) 22 (W)
Location as "NE/CNW/SW" or footage from lines. SW SW SW
Lease Owner El Dorado Refining Company
Lease Name WOLF B Well No. 1
Office Address Russell, Kansas
Character of Well (completed as Oil, Gas or Dry Hole) Dry
Date well completed 8-11 1955
Application for plugging filed 8-11 1955
Application for plugging approved 8-11 1955
Plugging commenced 8-11 1955
Plugging completed 8-11 1955
Reason for abandonment of well or producing formation Dry

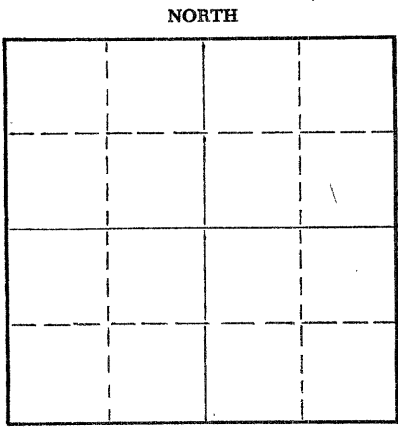

Locate well correctly on above Section Plat

If a producing well is abandoned, date of last production _____ 19____
Was permission obtained from the Conservation Division or its agents before plugging was commenced? Yes

Name of Conservation Agent who supervised plugging of this well Eldon Petty
Producing formation _____ Depth to top _____ Bottom _____ Total Depth of Well 3978 Feet
Show depth and thickness of all water, oil and gas formations.

OIL, GAS OR WATER RECORDS

CASING RECORD

FORMATION	CONTENT	FROM	TO	SIZE	PUT IN	PULLED OUT
				<u>8-5/8</u>	<u>203</u>	<u>None</u>

Describe in detail the manner in which the well was plugged, indicating where the mud fluid was placed and the method or methods used in introducing it into the hole. If cement or other plugs were used, state the character of same and depth placed, from _____ feet to _____ feet for each plug set.

1. Filled hole with heavy mud
2. Pushed plug to 198'
3. Dumped 1/2 sack hulls on top of plug
4. Mixed 15 sacks cement and dumped on top of hulls
5. Filled hole to top
6. Pushed plug to 40'
7. Dumped in 1/2 sack hulls
8. Mixed 10 sack cement and filled hole to top with same.

(If additional description is necessary, use BACK of this sheet)
Name of Plugging Contractor Jones, Shelburne & Farmer, Inc.
Address Russell, Kansas


STATE OF Kansas, COUNTY OF Russell, ss.
JOHN O. FARMER (employee of owner) or (owner or operator) of the above-described well, being first duly sworn on oath, says: That I have knowledge of the facts, statements, and matters herein contained and the log of the above-described well as filed and that the same are true and correct. So help me God.

(Signature) John O. Farmer
Russell, Kansas
(Address)

SUBSCRIBED AND SWORN TO before me this 18th day of August, 1955

My commission expires 10-11-58

Lucille Guiney **ELVED**
Notary Public.

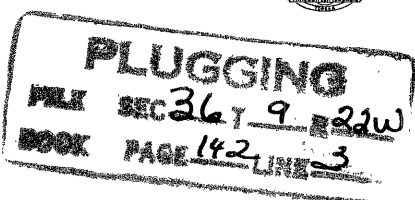


8-24-55

OPERATOR El Dorado Refining Company

FORMATION RECORD

ADDRESS Russell, Kansas

Give detailed description and thickness of all formations drilled through, contents of sand, whether dry, water, oil or gas.

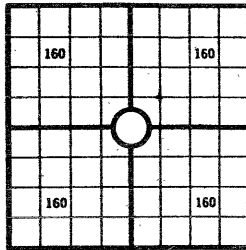640 Acres
N

Locate well correctly

COUNTY Graham SEC. 36 TWP. 9 RGE. 22
 COMPANY OPERATING El Dorado Refining Company
 OFFICE ADDRESS Russell, Kansas
 FARM NAME Wolfe B WELL NO. #1
 DRILLING STARTED 7-25, 1955 DRILLING FINISHED 8-9, 1955
 DATE OF FIRST PRODUCTION _____ COMPLETED _____
 WELL LOCATED SW 1/4 SW 1/4 SW 1/4 North of South
 Line and _____ ft. East of West Line of Quarter Section
 Elevation (Relative to sea level) DERRICK FLOOR _____ GROUND _____
 CHARACTER OF WELL (Oil, gas or dryhole) dry

OIL OR GAS SANDS OR ZONES

Name	From	To	Name	From	To
1			4		
2			5		
3			6		

Perforating Record If Any

Shot Record

Formation	From	To	No. of Shots	Formation	From	To	Size of Shot

CASING RECORD

Amount Set						Amount Pulled		Packer Record	
Size	Wt.	Thds.	Make	Ft.	In.	Size	Length	Depth Set	Make
8 5/8				203					

Liner Record: Amount _____ Kind _____ Top _____ Bottom _____

CEMENTING AND MUDDING

Size	Amount Set		Sacks Cement	Chemical		Method of Cementing	Amount	Mudding Method	Results (See Note)
	Ft.	In.		Gal.	Make				
8 5/8	203		135						

NOTE: What method was used to protect sands if outer strings were pulled? _____

NOTE: Were bottom hole plugs used? _____ If so, state kind, depth set and results obtained _____

TOOLS USED

Rotary Tools were used from _____ feet to _____ feet. Cable tools were used from _____ feet to _____ feet, and from _____ feet, and from _____ feet to _____ feet.
 Type-Rig _____

INITIAL PRODUCTION TEST

Describe briefly whether by flow through casing or by pumping _____

Amount of Oil Production _____ bbls. Size of choke, if any _____ Length of test _____ Water

Production _____ bbls. Gravity of oil _____ Type of Pump if pump is used, describe _____

Formation	Top	Bottom	Formation	Top	Bottom
Surface	0	203			
Shale-Sand	203	1000			
Shale-Sand	1000	1295			
Sand	1295	1495			
Red Bed & Shale	1495	1795			
Anhydrite	1795	1825			
Anhydrite	1825	1839			
Shale & Shells	1839	2180			
Shale & Lime	2180	2610			
Lime & Shale	2610	3690			
Lime	3690	3730			
Lime & Shale	3730	3885			
Lime & Shale	3885	3935			
Conglomerate	3935	3978			
TOPS:					
Elevation			2314		D.F
Anhydrite			1795		
Heebner			3508		
Toronto			3530		
Lansing			3546		
Arbuckle			3964		
T. D.			3978		
D. & A.					

I, the undersigned, being first duly sworn upon oath, state that this well record is true, correct and complete according to the records of this office and to the best of my knowledge and belief.

John D. Farmer
 Name and title of representative of company
 Vice President

Subscribed and sworn to before me this 15th day of August, 1955.My Commission expires 10-11-58
Lewis H. Hines
 Notary Public

WELL NO. #1 COUNTY Graham TWP 9 RGE 22 SEC 36

FARM NAME Wolfe B