15-173-00869-00-01

Form CP-4

STATE OF KANSAS
STATE CORPORATION COMMISSION

Give All Information Completely
Make Required Affidavit
Mail or Deliver Report to:
Conservation Division
State Corporation Commission
212 No. Market
Wichita, Kansas

WELL PLUGGING RECORD

NORTH

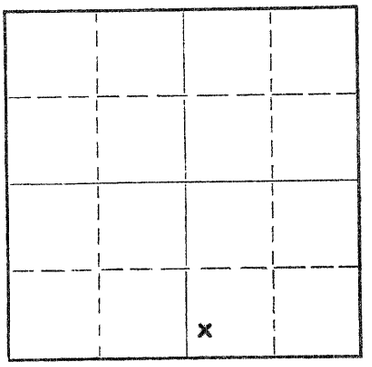

Locate well correctly on above Section Plat

Sedgwick County. Sec. 19 Twp. 27 Rge. 2 (E) (W)

Location as "NE/CNW¼SW¼" or footage from lines 23 F SL - 278' F W L - SE/4 SwSwSE

Lease Owner Whitney Operating and Engineering Co.

Lease Name Wheeler-Kelly Well No. 1

Office Address 902 First National Building Tulsa, Okla.

Character of Well (completed as Oil, Gas or Dry Hole) Oil Well

Date well completed 8-14-30 19

Application for plugging filed 5-16-66 19

Application for plugging approved 5-18-66 19

Plugging commenced 5-20-66 19

Plugging completed 5-26-66 19

Reason for abandonment of well or producing formation depleted

If a producing well is abandoned, date of last production 19

Was permission obtained from the Conservation Division or its agents before plugging was commenced? yes

Name of Conservation Agent who supervised plugging of this well Paul Turpin

Producing formation Depth to top Bottom Total Depth of Well 3247 Feet

Show depth and thickness of all water, oil and gas formations.

OIL, GAS OR WATER RECORDS — CASING RECORD

FORMATION	CONTENT	FROM	TO	SIZE	PUT IN	PULLED OUT
				20"	54"	none
				6 5/8"	2944'	2822.70
				5 3/16"	3240'	2898.03

Describe in detail the manner in which the well was plugged, indicating where the mud fluid was placed and the method or methods used in introducing it into the hole. If cement or other plugs were used, state the character of same and depth placed, from feet to feet for each plug set.

Fill hole with sand from 3247 to 3164 and dump 5 sacks of cement

Set 15' rock bridge from 200' to 185' and dump 3 cubic yards of ready mix concrete

Mud hole to 25' and dump 1 cubic yards of ready mix concrete

RECEIVED
STATE CORPORATION COMMISSION
6/3/66
JUN -3 1966

CONSERVATION DIVISION
Wichita, Kansas

(If additional description is necessary, use BACK of this sheet)

Name of Plugging Contractor Flint Engineering and Construction Co.

Address 2375 West Central El Dorado, Kansas

STATE OF Kansas, COUNTY OF Butler, ss.

(employee of owner) or (owner or operator) of the above-described well, being first duly sworn on oath, says: That I have knowledge of the facts, statements, and matters herein contained and the log of the above-described well as filed and that the same are true and correct. So help me God.

(Signature) Leanne Davis

(Address)

SUBSCRIBED AND SWORN TO before me this 1 day of June, 19 66

Ronald R. Hanson Ronald R. Hanson
Notary Public.

My commission expires September 27, 1967