

WELL PLUGGING RECORD

Give All Information Completely
Make Required Affidavit
Mail or Deliver Report to:
Conservation Division
State Corporation Commission
212 No. Market
Wichita, Kansas

Sedgwick County, Sec. 19 Twp. 27 Rge. 2 (E) (W)

Location as "NE/CNW/SW" or footage from lines NE NE NE

Lease Owner Whitney Operating and Engineering Co.

Lease Name Wheeler-Kelly Well No. 7

Office Address 902 First National Building Tulsa, Oklahoma

Character of Well (completed as Oil, Gas or Dry Hole) Oil Well

Date well completed 1-2-32 19

Application for plugging filed 5-16-66 19

Application for plugging approved 5-19-66 19


Plugging commenced 6-6-66 19

Plugging completed 6-8-66 19

Reason for abandonment of well or producing formation depleted

If a producing well is abandoned, date of last production _____ 19

Was permission obtained from the Conservation Division or its agents before plugging was commenced? yes

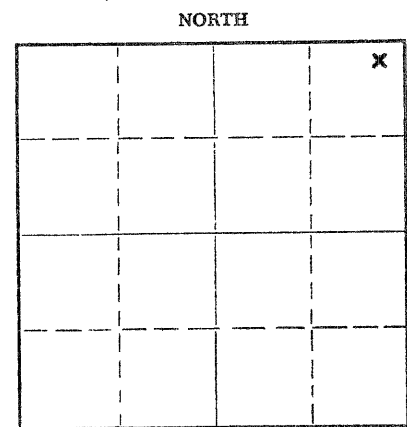

Locate well correctly on above Section Plat

Name of Conservation Agent who supervised plugging of this well Paul Turpin

Producing formation _____ Depth to top _____ Bottom _____ Total Depth of Well 3230 Feet

Show depth and thickness of all water, oil and gas formations.

OIL, GAS OR WATER RECORDS

CASING RECORD

FORMATION	CONTENT	FROM	TO	SIZE	PUT IN	PULLED OUT
				20	41'	none
				8"	2936'	192'
				7"	3223'	192'
				5 1/2"	3230	192'

Describe in detail the manner in which the well was plugged, indicating where the mud fluid was placed and the method or methods used in introducing it into the hole. If cement or other plugs were used, state the character of same and depth placed, from _____ feet to _____ feet for each plug set.

Hole had been plugged back to 2950' and perforated with top of perforation at 2940'

Filled hole with sand to 2900' and dumped 5 sacks of cement

Shot off 5 1/2", 7", & 8" casing at 192' and pulled out

Set 10' rock bridge to 182' and filled to surface with 17 yards of ready mix concrete

RECEIVED
STATE CORPORATION COMMISSION
6/15/66
JUN 15 1966
CONSERVATION DIVISION
WICHITA, KANSAS

(If additional description is necessary, use BACK of this sheet)

Name of Plugging Contractor Flint Engineering and Construction Co.

Address 2375 W. Central El Dorado, Kansas

STATE OF Kansas COUNTY OF Butler, ss.

_____, (employee of owner) or (owner or operator) of the above-described well, being first duly sworn on oath, says: That I have knowledge of the facts, statements, and matters herein contained and the log of the above-described well as filed and that the same are true and correct. So help me God.

(Signature) James Davis

(Address)

SUBSCRIBED AND SWORN TO before me this 13 day of June, 19 66

Ronald R. Hanson

Ronald R. Hanson
Notary Public.

Sept. 27, 1967

My commission expires _____