

GR

STATE OF KANSAS
STATE CORPORATION COMMISSION

Give All Information Completely
Make Required Affidavit
Mail or Deliver Report to:
Conservation Division
State Corporation Commission
212 No. Market
Wichita, Kansas

WELL PLUGGING RECORD

approx 100' W S2N2NE L's plat

Sedgwick County, Sec. 19 Twp. 27 Rge. 2 (E) (X)

Location as "NE/CNW4SW4" or footage from lines NW SW SE NW SE NE 1/4 2/4

Lease Owner Whitney Operating and Engineering Co.

Lease Name Wheeler-Kelly Well No. 6

Office Address 902 First National Building Tulsa, Oklahoma

Character of Well (completed as Oil, Gas or Dry Hole) Oil Well

Date well completed 9-26-31 19

Application for plugging filed 5-16-66 19

Application for plugging approved 5-19-66 19


Plugging commenced 6-9-66 19

Plugging completed 6-14-66 19

Reason for abandonment of well or producing formation depleted

If a producing well is abandoned, date of last production 19

Was permission obtained from the Conservation Division or its agents before plugging was commenced? yes

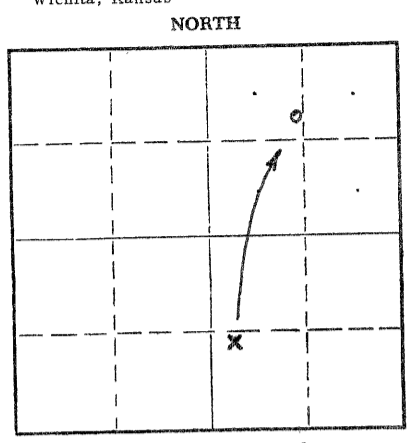

Locate well correctly on above Section Plat

Name of Conservation Agent who supervised plugging of this well Paul Turpin

Producing formation _____ Depth to top _____ Bottom _____ Total Depth of Well 3249 Feet

Show depth and thickness of all water, oil and gas formations.

OIL, GAS OR WATER RECORDS

CASING RECORD

FORMATION	CONTENT	FROM	TO	SIZE	PUT IN	PULLED OUT
				15 1/2	77'	none
				7"	3076'	300'
				5 1/2	3231'	2000'

Describe in detail the manner in which the well was plugged, indicating where the mud fluid was placed and the method or methods used in introducing it into the hole. If cement or other plugs were used, state the character of same and depth placed, from _____ feet to _____ feet for each plug set.

Fill hole with sand from 3249' to 3200' and dump 5 sacks of cement

Set 15' rock bridge from 200' to 185' and dump 10 cubic yards of ready mix concrete to cellar

RECEIVED
STATE CORPORATION COMMISSION
6/23/66
JUN 23 1966

CONSERVATION DIVISION
Wichita, Kansas

(If additional description is necessary, use BACK of this sheet)
Name of Plugging Contractor Flint Engineering and Construction Co.
Address 2375 W. Central El Dorado, Kansas

STATE OF Kansas, COUNTY OF Butler, ss.
(employee of owner) or (owner or operator) of the above-described well, being first duly sworn on oath, says: That I have knowledge of the facts, statements, and matters herein contained and the log of the above-described well as filed and that the same are true and correct. So help me God.

(Signature) Jeanne Davis

(Address)

SUBSCRIBED AND SWORN to before me this 17 day of June, 19 66

Ronald R. Hanson
Notary Public.

My commission expires Sept. 27, 1967