

15-173-00798-00-01

STATE OF KANSAS
STATE CORPORATION COMMISSION
Give All Information Completely
Make Required Affidavit
Mail or Deliver Report to:
Conservation Division
State Corporation Commission
800 Bittling Building
Wichita, Kansas

WELL PLUGGING RECORD


Sedgwick County, Sec. 14 Twp. 26 Rge. 2 (E) (W)
Location as "NE/CNW¹/₄SW¹/₄" or footage from lines Center NW NW SW

Lease Owner Gulf Oil Corporation
Lease Name Rose Hamant Well No. 2
Office Address P. O. Box 661, Tulsa, Oklahoma

Character of Well (completed as Oil, Gas or Dry Hole) Oil
Date well completed June 7 1929
Application for plugging filed August 28 1950
Application for plugging approved August 30 1950
Plugging commenced September 21 1950
Plugging completed October 8 1950

Reason for abandonment of well or producing formation Well no longer economical to operate.
If a producing well is abandoned, date of last production May 1944

Was permission obtained from the Conservation Division or its agents before plugging was commenced? Yes

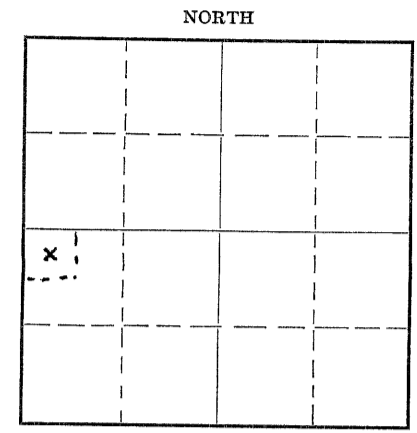

Locate well correctly on above Section Plat

Name of Conservation Agent who supervised plugging of this well D. C. Lilley
Producing formation Wilcox Depth to top 3346' Bottom 3370' Total Depth of Well 3370' Feet
Show depth and thickness of all water, oil and gas formations.

OIL, GAS OR WATER RECORDS

CASING RECORD

Formation	Content	From	To	Size	Put In	Pulled Out
				8-5/8"	3117'	1523'
				7"	3337'	3323'

Describe in detail the manner in which the well was plugged, indicating where the mud fluid was placed and the method or methods used in introducing it into the hole. If cement or other plugs were used, state the character of same and depth placed, from _____ feet to _____ feet for each plug set.

Mudded bottom of hole set rock bridge 3226' to 3336'. Dumped 5 sacks cement on bridge at 3326'. Mudded hole to 3105' and set rock bridge to 3095'; then dumped 4 sacks cement on bridge. Mudded hole to 150' and set rock bridge to 140'; then dumped 15 sacks cement on bridge. Mudded hole to 10' of surface, set rock bridge and capped with 5 sacks of cement.

(If additional description is necessary, use BACK of this sheet)

Correspondence regarding this well should be addressed to Mr. S. G. Sanderson
Address P. O. Box 661, Tulsa, Oklahoma

STATE OF Kansas, COUNTY OF Rice, ss.
H. H. Wright (employee of owner) or (owner or operator) of the above-described well,

being first duly sworn on oath, says: That I have knowledge of the facts, statements, and matters herein contained and the log of the above-described well as filed and that the same are true and correct. So help me God.

(Signature) *H. H. Wright*
P. O. Box 544, Chase, Kansas (Address)

SUBSCRIBED AND SWORN TO before me this 11th day of October

My commission expires April 14, 1957

RECEIVED
STATE CORPORATION COMMISSION
OCT 14 1950
Notary Public.

PLUGGING
FILE SEC 14 T 26 R 2E
BOOK PAGE 24 LINE 32