


Give All Information Completely
Make Required Affidavit
Mail or Deliver Report to:
Conservation Division
State Corporation Commission
211 No. Broadway
Wichita, Kansas

WELL PLUGGING RECORD

NORTH

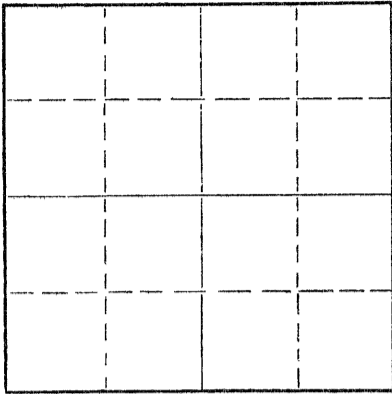

Locate well correctly on above
Section Plat

Sedgwick County. Sec. 14 Twp. 26 Rge. 2E (E) (W//)
Location as "NE/CNW/SW" or footage from lines SE NW NE
Lease Owner Warren Winne Oil Company
Lease Name ~~Bore~~ E. C. Borg A ^{KCC 2412} Well No. 1-A
Office Address 5503 E. Kellogg - Wichita, Kans.
Character of Well (completed as Oil, Gas or Dry Hole) D&A
Date well completed ~~xxxx~~ 19
Application for plugging filed 5/1/59 19
Application for plugging approved 5/1/59 19
Plugging commenced 5/1/59 19
Plugging completed 5/1/59 19
Reason for abandonment of well or producing formation _____

If a producing well is abandoned, date of last production 19
Was permission obtained from the Conservation Division or its agents before plugging was commenced? Yes

Name of Conservation Agent who supervised plugging of this well Lee Guthrie
Producing formation _____ Depth to top _____ Bottom _____ Total Depth of Well 3193' Feet
Show depth and thickness of all water, oil and gas formations.

OIL, GAS OR WATER RECORDS

CASING RECORD

FORMATION	CONTENT	FROM	TO	SIZE	PUT IN	PULLED OUT

Describe in detail the manner in which the well was plugged, indicating where the mud fluid was placed and the method or methods used in introducing it into the hole. If cement or other plugs were used, state the character of same and depth placed, from _____ feet to _____ feet for each plug set.

Mudded hole to 160' set plug hulls. 15 sacks cement mud to 30 set plug hulls, 8 sacks cement which filled to surface. Put 2 sacks in rat hole.

RECEIVED
STATE CORPORATION COMMISSION
9/17/63
SEP 17 1963

CONSERVATION DIVISION
Wichita, Kansas

(If additional description is necessary, use BACK of this sheet)

Name of Plugging Contractor Warren R. Winnie Drilling Company
Address Wichita, Kansas.

STATE OF Kansas, COUNTY OF Sedgwick, ss.

(employee of owner) or (owner or operator) of the above-described well, being first duly sworn on oath, says: That I have knowledge of the facts, statements, and matters herein contained and the log of the above-described well as filed and that the same are true and correct. So help me God.

(Signature) Warren R. Winnie
5503 E. Kellogg (Address)

SUBSCRIBED AND SWORN TO before me this 13 day of Sept, 1963

My commission expires 6-14-64
Maipied Hates Notary Public.



15-173-03653-00-00

WELL LOG BUREAU—KANSAS GEOLOGICAL SOCIETY
50S East Murdock, Wichita, Kansas




Company- WARREN R. WINNE
Farm- Borg "A" No. 1

SEC. 14 T. 26 R2E
SE NW NE

Total Depth. 3193'
Comm. 4-21-59 Comp. 5-1-59 ¹²⁵⁰₂₄₀
Shot or Treated.
Contractor. Warren R. Winne
Issued. 3-25-61

County Sedgwick
KANSAS

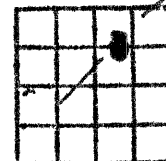

CASING:

8" 130'

Elevation. 1370' RB

Production. DRY

Figures Indicate Bottom of Formations.

COMPLETE DRILLERS LOG NOT AVAILABLE.

TOPS: SCOUT	
Kansas City	2408
B/Kansas City	2571
Rew. Mississippi	2871
Mississippi	2879
Kinderhook	3136
Viola	3185