

15-173-00802-00-00


STATE OF KANSAS  
STATE CORPORATION COMMISSION

Give All Information Completely  
Make Required Affidavit  
Mail or Deliver Report to:  
Conservation Division  
State Corporation Commission  
800 Bittling Building  
Wichita, Kansas

WELL PLUGGING RECORD

Sedgwick County. Sec. 14. Twp. 26S Rge. 2 (E) (W)

Location as "NE/4CNW/4SW/4" or footage from lines NW/4 SW/4 NW/4  
Lease Owner Gulf Oil Corporation  
Lease Name Rose Hamant Well No. 9  
Office Address P. O. Box 661, Tulsa 2, Oklahoma  
Character of Well (completed as Oil, Gas or Dry Hole) Oil  
Date well completed April 10 19.33  
Application for plugging filed August 29 19.50  
Application for plugging approved September 1 19.50  
Plugging commenced October 9 19.50  
Plugging completed October 29 19.50  
Reason for abandonment of well or producing formation No longer economical to operate.  
If a producing well is abandoned, date of last production June 26 19.45  
Was permission obtained from the Conservation Division or its agents before plugging was commenced? Yes

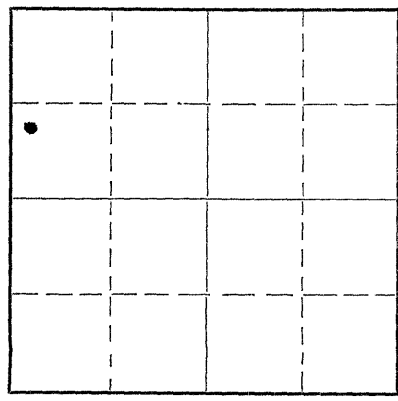

Locate well correctly on above Section Plat

Name of Conservation Agent who supervised plugging of this well D. C. Lilley  
Producing formation Simpson Dolomite Depth to top 3156 1/2 Bottom 3159 Total Depth of Well 3159 Feet  
Show depth and thickness of all water, oil and gas formations.

OIL, GAS OR WATER RECORDS CASING RECORD

Formation	Content	From	To	Size	Put In	Pulled Out
				12-1/2"	109'	None
				8-1/4"	3145'	1614'

Describe in detail the manner in which the well was plugged, indicating where the mud fluid was placed and the method or methods used in introducing it into the hole. If cement or other plugs were used, state the character of same and depth placed, from.....feet to.....feet for each plug set.

Hole mudded to 1886'; set rock bridge 1886' to 1882' and dumped five sacks of cement at 1882'. Mudded hole to 150'. Set rock bridge 150' to 140' and dumped fifteen sacks of cement on bridge. Mudded hole to 10' and capped with five sacks of cement.

RECEIVED  
STATE CORPORATION COMMISSION  
2/8/51  
FEB 8 1951  
CONSERVATION DIVISION  
Wichita, Kansas

(If additional description is necessary, use BACK of this sheet)

Correspondence regarding this well should be addressed to S. G. Sanderson  
Address P. O. Box 661, Tulsa 2, Oklahoma.

STATE OF Kansas, COUNTY OF Rice, ss.  
W. H. Duley (employee of owner) or (owner or operator) of the above-described well, being first duly sworn on oath, says: That I have knowledge of the facts, statements, and matters herein contained and the log of the above-described well as filed and that the same are true and correct. So help me God.

(Signature) W. H. Duley

P. O. Box 544, Chase, Kansas (Address)

SUBSCRIBED AND SWORN to before me this 31st day of October, 19.50

My commission expires April 14, 1952 Notary Public.

22-7877-s 4-49-10M

767

PLUGGING  
FILE SEC 14 T. 26 R  
BOOK PAGE 25 LINE 4

