


STATE OF KANSAS
STATE CORPORATION COMMISSION

Give All Information Completely
Make Required Affidavit
Mail or Deliver Report to:
Conservation Division
State Corporation Commission
800 Bittling Building
Wichita, Kansas

15-173-00797-00-00

WELL PLUGGING RECORD

NORTH

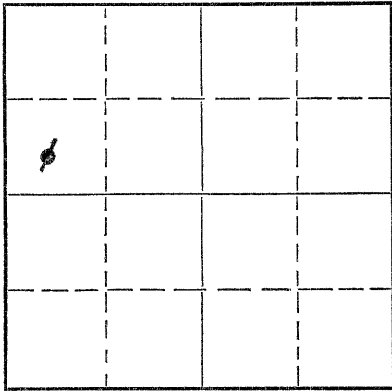

Locate well correctly on above
Section Plat

Sedgwick

County. Sec. 14 Twp. 26S Rge. 2 (E) *WV*

Location as "NE/CNW $\frac{1}{4}$ /SW $\frac{1}{4}$ " or footage from lines 330' NSL & 330' EWL of NW $\frac{1}{4}$
 Lease Owner *Gulf Oil Corporation*
 Lease Name *Rose R. Hamant* Well No. *1*
 Office Address *Box 661, Tulsa, 2, Oklahoma*
 Character of Well (completed as Oil, Gas or Dry Hole) *Oil*
 Date well completed *5-29* 19 *29*
 Application for plugging filed 19
 Application for plugging approved *1-21* 19 *52*
 Plugging commenced *12-28* 19 *51*
 Plugging completed *1-20* 19 *52*
 Reason for abandonment of well or producing formation *Uneconomical to produce.*

If a producing well is abandoned, date of last production *10-24* 19 *51*
 Was permission obtained from the Conservation Division or its agents before plugging was commenced? *Yes.*

Name of Conservation Agent who supervised plugging of this well *Mr. D. C. Lilley*
 Producing formation *Hunton Lime* Depth to top *3163'* Bottom *3167'* Total Depth of Well *3272* Feet
 Show depth and thickness of all water, oil and gas formations.

OIL, GAS OR WATER RECORDS

CASING RECORD

Formation	Content	From	To	Size	Put In	Pulled Out
				13"	113'	0'
				8-5/8"	3062'	1585'
				7"	3270'	1635'
				5-1/2"	65'	0'

Describe in detail the manner in which the well was plugged, indicating where the mud fluid was placed and the method or methods used in introducing it into the hole. If cement or other plugs were used, state the character of same and depth placed, from _____ feet to _____ feet for each plug set.

Dumped sand from TD to 3142' and dumped three sacks of cement. Shot casing at 1632' and recovered 1635' of 7". Mudded hole to 1635' and set 5' rock bridge and dumped three sacks of cement on bridge. Shot 8-5/8" casing at 1585' and recovered 1585' and mudded hole to 150'. Set 10' rock bridge and dumped 15 sacks of cement on bridge. Mudded hole to 20' and set 5' rock bridge and capped with five sacks of cement.

(If additional description is necessary, use BACK of this sheet)

Name of Plugging Contractor *Pipe Pulling, Inc.*
 Address *620 W. Broadway, Stafford, Kansas.*

STATE OF KANSAS, COUNTY OF RICE, ss.
W. H. Duley (employee of owner) *W. H. Duley* of the above-described well,
 being first duly sworn on oath, says: That I have knowledge of the facts, statements, and matters herein contained and the log of the above-described well as filed and that the same are true and correct. So help me God.

(Signature) *W. H. Duley*
P. O. Box 544, Chase, Kansas
 (Address)

SUBSCRIBED AND SWORN to before me this *25th* day of *January*, 19*52*

My commission expires *April 14, 1952* Notary Public.

23-8390-s 6-51-20M

PLUGGING
 FILE REC 147 26 R 26
 BOOK PAGE 139 LINE 20

JAN 24 1952

WELL RECORD

WELL NO.

COMPANY

LEASE

WELL NO.

FORMATION RECORD

CATH-COLLING DESIGN

From	To	Formation
0	40	Soil
40	47	Water sand
47	70	Shale
70	112	Lime and sand
112	130	Lime shells
130	200	Shale
200	210	Lime shells
210	230	Shale
