

Give All Information Completely
Make Required Affidavit
Mail or Deliver Report to:
Conservation Division
State Corporation Commission
211 No. Broadway
Wichita, Kansas

WELL PLUGGING RECORD

Sedgwick County, Sec. 3 Twp. 26 Rge. 2 (E) (XXX)

Location as "NE/CNW%SW%" or footage from lines SW SW NE

Lease Owner Acme Oil Corporation

Lease Name Erdwien "C" Well No. 1

Office Address 404 One Twenty Bldg., Wichita, Kansas

Character of Well (completed as Oil, Gas or Dry Hole) SWD

Date well completed 11-19-62 19

Application for plugging filed 8-20-65 19

Application for plugging approved 8-22-65 19


Plugging commenced 10-7-65 19

Plugging completed 10-8-65 19

Reason for abandonment of well or producing formation depleted

If a producing well is abandoned, date of last production 19

Was permission obtained from the Conservation Division or its agents before plugging was commenced? yes

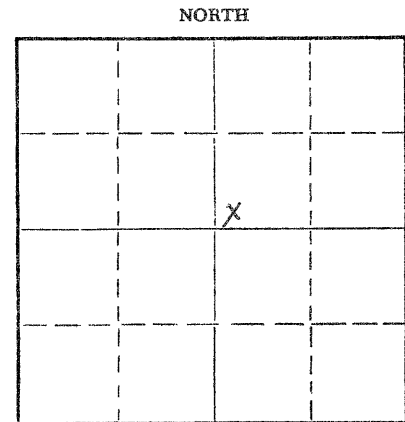

Locate well correctly on above Section Plat

Name of Conservation Agent who supervised plugging of this well Paul Turpin

Producing formation Depth to top Bottom Total Depth of Well 2883 Feet

Show depth and thickness of all water, oil and gas formations.

OIL, GAS OR WATER RECORDS

CASING RECORD

FORMATION	CONTENT	FROM	TO	SIZE	PUT IN	PULLED OUT
				8 5/8	134	none
				4 1/2	2880	539.21

Describe in detail the manner in which the well was plugged, indicating where the mud fluid was placed and the method or methods used in introducing it into the hole. If cement or other plugs were used, state the character of same and depth placed, from feet to feet for each plug set.

Fill hole with sand from 2883' to 2870' and dump 5 sacks cement.
Set 10' rock bridge from 180' to 170' and dump 20 sacks cement.
Mud hole to 40', set 10' rock bridge to 30' and dump 10 sacks cement to surface.

RECEIVED
OCT 2 1965
10-18-65
CONSERVATION DIVISION
WICHITA, KANSAS

(If additional description is necessary, use BACK of this sheet)

Name of Plugging Contractor Flint Engineering & Construction Company

Address Box 950, El Dorado, Kansas

STATE OF KANSAS, COUNTY OF BUTLER, ss.

(employee of owner) or (owner or operator) of the above-described well, being first duly sworn on oath, says: That I have knowledge of the facts, statements, and matters herein contained and the log of the above-described well as filed and that the same are true and correct. So help me God.

(Signature) [Signature]

El Dorado, Kansas

(Address)

SUBSCRIBED AND SWORN TO before me this 13th day of October, 19 65

My commission expires 9-27-67

[Signature] Notary Public.

3-26-2E
WELL LOG

COMPANY: Acme Oil Corporation ✓
512 Orpheum Building
Wichita, Kansas

LEASE: Erdwien "C" #1

LOCATION: SW SW NE
Sec. 3-26S-2E
Sedgwick County, Kansas

CONTRACTOR: Canaday Drilling Company
6427 East Kellogg
Wichita, Kansas

CASING: 134 feet of 8 5/8 inch with 100 sacks 2% C.C.
2880 feet of 4 1/2 inch with 75 sacks.

COMMENCED: November 12, 1962
COMPLETED: November 19, 1962
ELEVATION: 1371 K.B.
TOTAL DEPTH: 2883 feet

FIGURES INDICATE BOTTOM OF FORMATION

70	Shale	1988	Lime & Shale
134	Lime & Shale	2160	Shale - Lime
340	Lime	2290	Lime & Shale
580	Lime & Shale	2863	Shale - Lime
1030	Shale & Shells	2876	Sand
1370	Shale	2883	Miss. T.D.
1575	Shale & Lime		

OCT 20 1962
CONSERVATION DIVISION
Wichita, Kansas

I, Granville E. Canaday, Jr. of
CANADAY DRILLING COMPANY certify
the above Well Log to be true to
the best of my knowledge.

Granville E. Canaday, Jr.
Granville E. Canaday, Jr.

Subscribed and sworn to before me, a
Notary Public in and for Sedgwick County,
Kansas this 20th day of November, 1962.

Ralph E. Arbogast
My Commission expires 9-15-66

WELL LOG

Company: Acme Oil Corporation
404 One Twenty Building
Wichita, Kansas

Lease: Erdwien "C" #1

Location: SW SW NE
Sec. 3-26S-2E
Sedgwick Co., Ks.

DEEPENING RECORD

	2883	R.T.D.
2883 is	2890	Depth Correction
	2895	Weathered Chert
	2898	Shale
	2901	White Chert
(oil & water)	2906	White Chert
	2907	White Line T.D.

RECORDED
 INDEXED
 OCT 13 1953
 UPTON
 CORP. OF KANSAS
 WICHITA, KANSAS