


WELL PLUGGING RECORD

Give All Information Completely
Make Required Affidavit
Mail or Deliver Report to:
Conservation Division
State Corporation Commission
212 North Market, Insurance Bldg.
Wichita, Kansas

NORTH

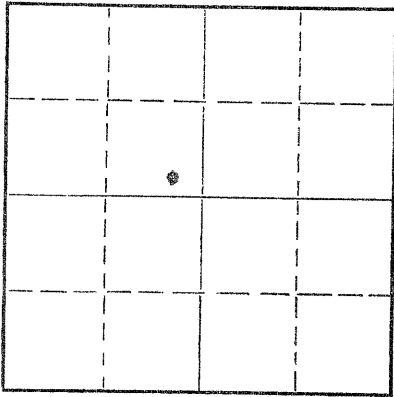

Locate well correctly on above
Section Plat

Sedgwick County. Sec. 3 Twp. 26 Rge. 2 (E) 1W)
Location as "NE/CNW/SW" or footage from lines SE SE NW
Lease Owner Harvest Queen Mill & Elevator Company.
Lease Name Alva A. Feik.
Office Address Box 1000. Plainview, Texas. 79073 Well No. 5
Character of Well (completed as Oil, Gas or Dry Hole) Oil
Date well completed January 9th, 19 63
Application for plugging filed November 30th, 19 66
Application for plugging approved December 1st, 19 66
Plugging commenced December 7th, 19 66
Plugging completed December 9th, 19 66
Reason for abandonment of well or producing formation Very small well and finally became unprofitable.

If a producing well is abandoned, date of last production June 19 64
Was permission obtained from the Conservation Division or its agents before plugging was commenced? Yes

Name of Conservation Agent who supervised plugging of this well Mr. Paul Turpin.
Producing formation Burgess Depth to top 2883 Bottom 2890 Total Depth of Well 2929 Feet
Show depth and thickness of all water, oil and gas formations.

OIL, GAS OR WATER RECORDS

CASING RECORD

FORMATION	CONTENT	FROM	TO	SIZE	PUT IN	PULLED OUT
Burgess Sand	Oil	2883	2890	5 1/2"	2928	2230 feet
Mississippian	Water	2900	2990			
Surface Casing				8 5/8"	202	None.

Describe in detail the manner in which the well was plugged, indicating where the mud fluid was placed and the method or methods used in introducing it into the hole. If cement or other plugs were used, state the character of same and depth placed, from 2775 feet to 2825 feet for each plug set.

Pumped Plug down to 2775 using ten sacks of cement to cover perforations.
Pumped Rotary Mud to 200 feet. Set Cement plug with twenty sacks of cement in surface casing. Mud to top and used five sacks as top plug.

Note: this well was originally drilled to 2929 feet and salt water was encountered in Mississippian. Well was plugged back to 2990 feet at bottom of Burgess. Burgess Sand was perforated at 2883 to 2886 1/2 feet.

RECEIVED
STATE CORPORATION COMMISSION
DEC 22 1966
CONSERVATION DIVISION
WICHITA, KANSAS

(If additional description is necessary, use BACK of this sheet)

Name of Plugging Contractor Reeves Casing Pulling Contractor.
Address 3251 SE 29th, Street. Oklahoma City, Oklahoma.

STATE OF TEXAS, COUNTY OF HALE, ss.
Ray Simmons.

(employee of owner) or (owner or operator) of the above-described well, being first duly sworn on oath, says: That I have knowledge of the facts, statements, and matters herein contained and the log of the above-described well as filed and that the same are true and correct. So help me God.

(Signature) Ray Simmons
Box 1000. Plainview, Texas. (Address)

SUBSCRIBED AND SWORN TO before me this 20th day of December, 19 66.

My commission expires
GLENN CAUGHRON
Notary Public, Hale County, Texas
Commission Expires June 1, 1967

Glenn Caughron
Notary Public.

