


STATE OF KANSAS
STATE CORPORATION COMMISSION

WELL PLUGGING RECORD

Give All Information Completely
Make Required Affidavit
Mail or Deliver Report to:
Conservation Division
State Corporation Commission
211 No. Broadway
Wichita, Kansas

Sedgwick County. Sec. 3 Twp. 26S Rge. 2 (E) (W)
Location as "NE/CNW/SW" or footage from lines SW NE SW
Lease Owner C. P. Garretson
Lease Name Baker Well No. 2
Office Address Colorado-Derby Building, Wichita, Kansas
Character of Well (completed as Oil, Gas or Dry Hole) Dry hole
Date well completed September 8 1963
Application for plugging filed September 8 1963
Application for plugging approved September 8 1963
Plugging commenced September 8 1963
Plugging completed September 8 1963
Reason for abandonment of well or producing formation No commercial shows

NORTH

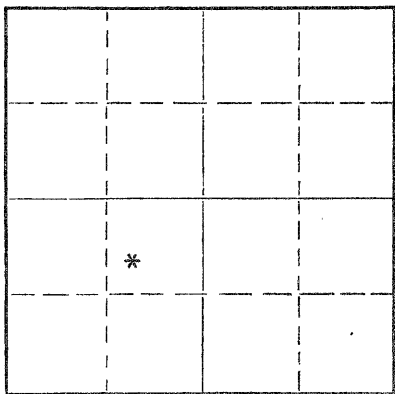

Locate well correctly on above
Section Plat

If a producing well is abandoned, date of last production _____ 19____
Was permission obtained from the Conservation Division or its agents before plugging was commenced? Yes

Name of Conservation Agent who supervised plugging of this well Paul Turpin
Producing formation None Depth to top _____ Bottom _____ Total Depth of Well 2939 Feet
Show depth and thickness of all water, oil and gas formations.

OIL, GAS OR WATER RECORDS

CASING RECORD

FORMATION	CONTENT	FROM	TO	SIZE	PUT IN	PULLED OUT

Describe in detail the manner in which the well was plugged, indicating where the mud fluid was placed and the method or methods used in introducing it into the hole. If cement or other plugs were used, state the character of same and depth placed, from _____ feet to _____ feet for each plug set.

Mudded hole to 188 feet with 44 viscosity mud. Set dry hole plug @ 188 feet. Added 1/2 sack hulls and 18 sacks cement. Mudded hole to 30 feet. Set dry hole plug. Added 1/4 sack hulls and 8 sacks cement. Capped rat hole with 2 sacks cement.

RECEIVED
STATE CORPORATION COMMISSION

SEP 11 1963
9-11-63

STATE CORPORATION COMMISSION
WICHITA, KANSAS

(If additional description is necessary, use BACK of this sheet)

Name of Plugging Contractor Canaday Drilling Company
Address 6427 East Kellogg, Wichita, Kansas

STATE OF KANSAS, COUNTY OF SEDGWICK, ss.
Granville E. Canaday, Jr. (employee of owner) or (owner or operator) of the above-described well, being first duly sworn on oath, says: That I have knowledge of the facts, statements, and matters herein contained and the log of the above-described well as filed and that the same are true and correct. So help me God.

(Signature) Granville E. Canaday, Jr.
6427 East Kellogg, Wichita, Kansas
(Address)

SUBSCRIBED AND SWORN TO before me this 9th day of September, 1963

My commission expires My Commission Expires Jan. 31, 1967

Pat Leashaw
Notary Public.



9

WELL LOG

COMPANY: C. P. Garretson
Colorado-Derby Bldg.
Wichita, Kansas

COMMENCED: August 31, 1963

COMPLETED: September 8, 1963

LEASE: Baker #2

TOTAL DEPTH: 2939 feet

LOCATION: SW NE SW Sec. 3-26S-2E
Sedgwick County, Kansas

ELEVATION: 1403 K.B.

CONTRACTOR: Canaday Drilling Company
6427 East Kellogg
Wichita, Kansas

CASING: 152 feet of 8 5/8" with 125 sacks

FIGURES INDICATE BOTTOM OF FORMATION

520	Lime-Shale	2461	Shale & Lime
583	Shale & Lime	2585	Lime
835	Lime & Shale	2700	Lime & Shale
1280	Shale & Shells	2820	Shale & Lime
1540	Shale w/Lime	2895	Shale
1770	Lime & Shale	2910	Shale-Lime
2050	Shale & Lime	2915	Sand-Chert
2215	Lime w/Shale	2928	Mississippian
2350	Lime & Shale	2939	Miss. Lime

RECEIVED
STATE CORPORATION COMMISSION

SEP 11 1963

CONSERVATION DIVISION
Wichita, Kansas

I, Granville E. Canaday, Jr. of
CANADAY DRILLING COMPANY certify
the above Well Log to be true to
the best of my knowledge.

Granville E. Canaday Jr.

Subscribed and sworn to before me, a Notary Public in and for Sedgwick
County, Kansas this 10th day of September, 1963.

My Commission Expires Jan. 31, 1967

Oat Leashan