


Give All Information Completely
Make Required Affidavit
Mail or Deliver Report to:
Conservation Division
State Corporation Commission
211 No. Broadway
Wichita, Kansas

WELL PLUGGING RECORD

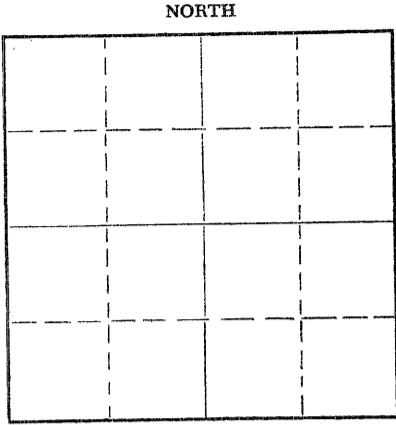

Locate well correctly on above Section Plat

Sedgwick County, Sec. 3 Twp. 26S Rge. 2E (E) (W)
Location as "NE/CNW/SW" or footage from lines SW NW SW
Lease Owner Gearhart-Canaday Drilg. Co.
Lease Name Baker "A" Well No. 2
Office Address 6427 East Kellogg
Character of Well (completed as Oil, Gas or Dry Hole) Dry Hole
Date well completed 9:00 A.M. 6-18 19 61
Application for plugging filed 6-18 19 61
Application for plugging approved 6-18 19 61
Plugging commenced 6-18 19 61
Plugging completed 11:00 A.M. 6-18 19 61
Reason for abandonment of well or producing formation Dry Hole

If a producing well is abandoned, date of last production _____ 19____
Was permission obtained from the Conservation Division or its agents before plugging was commenced? Yes

Name of Conservation Agent who supervised plugging of this well Lee Guthrie
Producing formation None Depth to top _____ Bottom _____ Total Depth of Well 2921 Feet
Show depth and thickness of all water, oil and gas formations.

OIL, GAS OR WATER RECORDS

CASING RECORD

FORMATION	CONTENT	FROM	TO	SIZE*	PUT IN	PULLED OUT
		0	150	8 5/8	150	None

Describe in detail the manner in which the well was plugged, indicating where the mud fluid was placed and the method or methods used in introducing it into the hole. If cement or other plugs were used, state the character of same and depth placed, from _____ feet to _____ feet for each plug set.

Filled hole to 180' with drilling mud. Run Halliburton Plug and bridged with 1/4 sack hulls. Dumped 150 sacks cement on bridge. Filled hole to 35' with drilling mud. Run Halliburton Plug and bridged with 1/4 sack hulls. Dumped 10 sacks cement on bridge. Bridged rat hole with 2 sacks cement. Cut Surface Pipe off 24" below ground level.

RECEIVED
STATE CORPORATION COMMISSION
6-28-61
JUN 28 1961
CONSERVATION DIVISION
Wichita, Kansas

(If additional description is necessary, use BACK of this sheet)
Name of Plugging Contractor Gearhart-Canaday Drilling Company
Address 6427 East Kellogg, Wichita, Kansas

STATE OF Kansas, COUNTY OF Sedgwick, ss.
Granville E. Canaday, Jr. (employee of owner) or (owner or operator) of the above-described well, being first duly sworn on oath, says: That I have knowledge of the facts, statements, and matters herein contained and the log of the above-described well as filed and that the same are true and correct. So help me God.

(Signature) Granville E. Canaday Jr.
6427 East Kellogg, Wichita, Kansas
(Address)

SUBSCRIBED AND SWORN TO before me this 19th day of June, 19 61

My commission expires May 7, 1962
Elmer E. Huffman Notary Public.

INVOICED
DATE 6-28-61
INV. NO. 3899-E

P

WELL LOG

COMPANY: Gearhart-Canaday Drlg. Co. COMMENCED: 6-11-61
 LEASE: Baker "A" #2 COMPLETED: 6-18-61
 LOCATION: SW NW SW 3-26S-2E TOTAL DEPTH: 2921'
 Sedgwick County, Kansas
 CONTRACTOR: Gearhart-Canaday Drilling Co.
 CASING: 150' of 8 5/8" w/100 sacks cement, 4% Ca.Cl.

FIGURES INDICATE BOTTOM OF FORMATION

140'	Shale	2911'	Conglomerate
150'	Lime	2921'	Lime & Chert
725'	Lime & Shale	2921'	T.D.
765'	Ankydrite		
800'	Lime & Shale		
1005'	Shale & Shells		
1630'	Shale & Lime		
1820'	Shale w/Lime		
1860'	Lime & Shale		
2192'	Shale & Lime		
2485'	Shale		
2518'	Lime		
2894'	Lime & Shale		
2898'	Sdy. Lime		

I, Granville E. Canaday, Jr., of Gearhart-Canaday Drilling Company, certify the above rotary log to be true & correct.

Granville E. Canaday Jr.
 Granville E. Canaday, Jr., Partner
 Gearhart-Canaday Drilling Company

Subscribed and sworn to before me, a notary public in and for Sedgwick County, Kansas, this 19th day of June, 1961.

Elmer E. Huffman
 My commission expires: *May 7, 1962*

RECEIVED
 STATE CORPORATION COMMISSION
 JUN 28 1961
 CONSERVATION DIVISION
 Wichita, Kansas