

R

STATE OF KANSAS
STATE CORPORATION COMMISSION

Form CP-4

Give All Information Completely
Make Required Affidavit
Mail or Deliver Report to:
Conservation Division
State Corporation Commission
211 No. Broadway
Wichita, Kansas

WELL PLUGGING RECORD

SEDGWICK County, Sec. 3 Twp. 26 Rge. 2E (E) (W)

Location as "NE/CNW/SW" or footage from lines NE-NW-SW

Lease Owner WM. JUSTICE

Lease Name BAKER

Office Address P.O. BOX 311, VALLEY CENTER, KANSAS Well No. 1

Character of Well (completed as Oil, Gas or Dry Hole) OIL

Date well completed _____ 19 _____

Application for plugging filed _____ 12-30 19 64

Application for plugging approved _____ 19 _____


Plugging commenced _____ 12-30 19 64

Plugging completed _____ 12-31 19 64

Reason for abandonment of well or producing formation DRY

If a producing well is abandoned, date of last production _____ 19 _____

Was permission obtained from the Conservation Division or its agents before plugging was commenced? YES

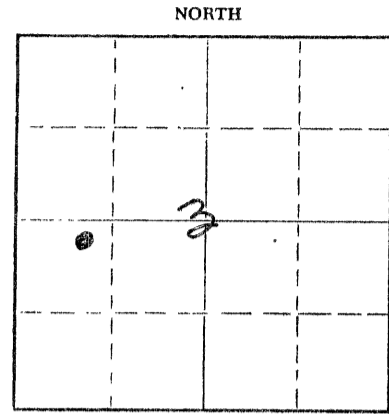

Locate well correctly on above Section Plat

Name of Conservation Agent who supervised plugging of this well PAUL TURPIN
Producing formation _____ Depth to top _____ Bottom _____ Total Depth of Well 2942' Feet
Show depth and thickness of all water, oil and gas formations.

OIL, GAS OR WATER RECORDS

CASING RECORD

FORMATION	CONTENT	FROM	TO	SIZE	PUT IN	PULLED OUT
				8-5/8"	142'	0
				4 1/2"	2942'	1625

Describe in detail the manner in which the well was plugged, indicating where the mud fluid was placed and the method or methods used in introducing it into the hole. If cement or other plugs were used, state the character of same and depth placed, from _____ feet to _____ feet for each plug set.

ROCKED 5' ON BOTTOM

DUMP 5 SACKS CEMENT

MUD TO 185'

20' Rock

DUMP 15 SACKS CEMENT

MUD TO 25'

DUMP 8 SACKS CEMENT

DIRT TO SURFACE

RECEIVED
STATE CORPORATION COMMISSION

FEB 1 1965

2-1-65

CONSERVATION DIVISION
Wichita, Kansas

No Log Available

(If additional description is necessary, use BACK of this sheet)
Name of Plugging Contractor WINFIELD OIL FIELD SERVICE, INC.
Address 2011 MAIN, WINFIELD, KANSAS

STATE OF Kansas COUNTY OF Sedgwick, ss.

William Justice (employee of owner) or (owner or operator) of the above-described well, being first duly sworn on oath, says: That I have knowledge of the facts, statements, and matters herein contained and the log of the above-described well as filed and that the same are true and correct. So help me God.

(Signature) William Justice

P.O. Box 311 Valley Center, Kansas (Address)

SUBSCRIBED AND SWORN to before me this 30th day of January, 1965

My commission expires May 14, 1968

Edel Spier Notary Public.