

SP


STATE OF KANSAS
STATE CORPORATION COMMISSION

WELL PLUGGING RECORD

Give All Information Completely
Make Required Affidavit
Mail or Deliver Report to:
Conservation Division
State Corporation Commission
212 North Market, Insurance Bldg.
Wichita, Kansas

Sedgwick County. Sec. 3 Twp. 26 Rge. 2 (E) (W)
Location as "NE/CNW/SW" or footage from lines SE SW NW (SE SW NW)
Lease Owner Harvest Queen Mill & Elevator Company.
Lease Name Alva A. Feik. Well No. 1
Office Address Box 1000. Plainview, Texas. 79073
Character of Well (completed as Oil, Gas or Dry Hole) Dry
Date well completed January 4th, 19 63
Application for plugging filed November 30th, 19 66
Application for plugging approved December 1st, 19 66
Plugging commenced December 10th, 19 66
Plugging completed December 16th, 19 66
Reason for abandonment of well or producing formation Dry Hole.

NORTH

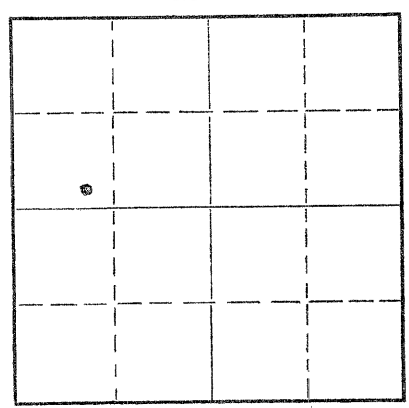

Locate well correctly on above Section Plat

If a producing well is abandoned, date of last production _____ 19 ____
Was permission obtained from the Conservation Division or its agents before plugging was commenced? Yes

Name of Conservation Agent who supervised plugging of this well Mr. Paul Turpin. 2550
Producing formation _____ Depth to top _____ Bottom _____ Total Depth of Well 2590 Feet
Show depth and thickness of all water, oil and gas formations.

OIL, GAS OR WATER RECORDS


CASING RECORD

FORMATION	CONTENT	FROM	TO	SIZE	PUT IN	PULLED OUT
				8 5/8"	196 ft.	None
				5 1/2"	2,590 ft	2,200 ft.

Describe in detail the manner in which the well was plugged, indicating where the mud fluid was placed and the method or methods used in introducing it into the hole. If cement or other plugs were used, state the character of same and depth placed, from 2350 feet to 2400 feet for each plug set.

Pumped Plug to 2350 Feet set 10 sacks cement to cover perforations.
Pumped Rotary Mud to 200 feet. Set 20 Sacks of Cement in 8 5/8" Surface Casing from 200 feet to approximately 100 feet of top.
Set 5 Sacks of cement in top of 8 5/8" Surface casing.

This was Kansas City Lime Test.

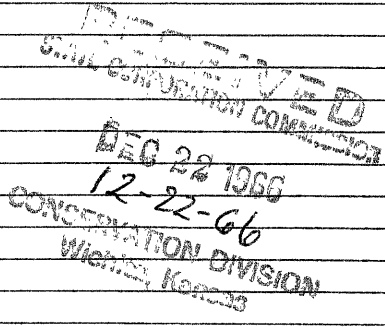

(If additional description is necessary, use BACK of this sheet)
Name of Plugging Contractor Reeves Casing Pulling Contractor.
Address 3251 SE 29th, Street. Oklahoma City.

STATE OF TEXAS, COUNTY OF HALE, ss.
Ray Simmons (employee of owner) or (~~owner or operator~~) of the above-described well, being first duly sworn on oath, says: That I have knowledge of the facts, statements, and matters herein contained and the log of the above-described well as filed and that the same are true and correct. So help me God.

(Signature) Ray Simmons

SUBSCRIBED AND SWORN TO before me this 20th day of December, 19 66.

(Address) Glenn Caughron
Glenn Caughron
Notary Public.

My commission expires _____

GLENN CAUGHRON
Notary Public, Hale County, Texas
Commission Expires June 1, 1967

