

DISTRICT CONSERVATION AGENT'S REPORT

TO:

State Corporation Commission
Conservation Division
800 Bitting Building
Wichita, Kansas

FILE NO. _____

LOCATION SW SW SESEC. 19 TWP. 27 RGE. 2E

Dry Hole _____ Abandoned Oil Well ☒ Abandoned Gas Well _____


I have today completed supervision of plugging of:

Well No. 2 Lease TrusteeOperator Chas. Stuckee Address Tulsa, OklaField Eastborough County SedgwickTotal Depth 3251 Feet.

(Describe briefly the manner in which the well was plugged)

Mud & rock to 2910 & 2 1/2 cu cement
Mud to 130'
Wood plug, rock & 15 cu cement
Mud to 5'
6 cu cement in top of hole and
base of cellar

RECORDED
5/23/50
MAY 23 1950

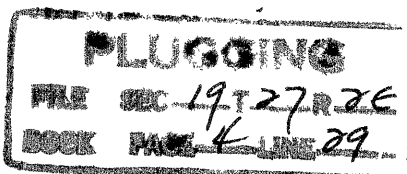

D. O. Peery
District Conservation Agent

Date May 23, 1950