


9

STATE OF KANSAS  
STATE CORPORATION COMMISSION

Form CP-4

Give All Information Completely  
Make Required Affidavit  
Mail or Deliver Report to:  
Conservation Division  
State Corporation Commission  
211 No. Broadway  
Wichita, Kansas

WELL PLUGGING RECORD

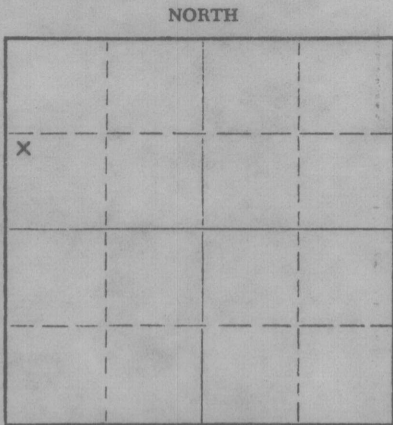

Sedgwick

County. Sec. 3 Twp. 26s Rge. 2 (E) E (W)

Location as "NE/CNW/SW" or footage from lines NW SW NW

Lease Owner Harvest Queen Mill & Elevator Co.

Lease Name Feik

Well No. 4

Office Address Box 991, Plainview, Texas 79073

Character of Well (completed as Oil, Gas or Dry Hole) oil

Date well completed 4-15 1962

Application for plugging filed 19

Application for plugging approved 19

Plugging commenced 4-06 1964

Plugging completed 4-07- 1964

Reason for abandonment of well or producing formation depleted

If a producing well is abandoned, date of last production 19

Was permission obtained from the Conservation Division or its agents before plugging was commenced? yes

Name of Conservation Agent who supervised plugging of this well Paul Turpin

Producing formation Depth to top Bottom Total Depth of Well 2888 Feet

Show depth and thickness of all water, oil and gas formations.

OIL, GAS OR WATER RECORDS

CASING RECORD

FORMATION	CONTENT	FROM	TO	SIZE	PUT IN	PULLED OUT
				8 5/8	200'	none
				4 1/2	2880.	2480.16

Describe in detail the manner in which the well was plugged, indicating where the mud fluid was placed and the method or methods used in introducing it into the hole. If cement or other plugs were used, state the character of same and depth placed, from feet to feet for each plug set.

Filled to 2880 feet with chat and dumped 5 sacks cement.  
Set 10 foot rock bridge at 220 feet and dumped 15 sacks cement.  
Mud hole to 30 feet, set 5 foot rock bridge and dumped 10 sacks cement to surface.

RECEIVED  
STATE CORPORATION COMMISSION  
APR 15 1964  
4-15-64  
CONSERVATION DIVISION  
Wichita, Kansas

Name of Plugging Contractor Flint Engineering & Construction Co.  
Address Box 950, El Dorado, Kansas

STATE OF Kansas, COUNTY OF Butler, ss.

(employee of owner) or (owner or operator) of the above-described well, being first duly sworn on oath, says: That I have knowledge of the facts, statements, and matters herein contained and the log of the above-described well as filed and that the same are true and correct. So help me God.

(Signature) Mary Payne  
El Dorado, Kansas  
(Address)

SUBSCRIBED AND SWORN to before me this 14th day of April, 1964

My commission expires Sept 27, 1967

Ronald R. Harrison  
Notary Public.

WELL LOG

*R*

Company: Harvest Queen Mill & Elevator  
Lease: Feik #4  
Location: NW SW NW Sec 3-26S-2E  
Sedgwick County, Kansas  
Contractor: Canaday Drilling Co.  
6427 E. Kellogg, Wichita, Kansas  
Casing: 200' of 8 5/8" W/200 sacks cement-2% CC

Commenced: 4-9-62  
Completed: 4-15-62  
Total Depth: 2883

FIGURES INDICATE BOTTOM OF FORMATION

200	Lime & Shale	2417	Lime & Shale
310	Shale & Lime	2790	Lime
575	Lime & Shale	2879	Shale
800	Shale & Lime	2883	Sand
1207	Shale w/Lime Strks.	2883	T.D.
1455	Shale & Shells		
1760	Shale		
1960	Shale & Lime		
2120	Lime & Shale		
2300	Lime & Shale		

**RECEIVED**  
STATE CORPORATION COMMISSION

MAY 8 1964

CONSERVATION DIVISION  
Wichita, Kansas

I, Granville E. Canaday Jr. of Canaday Drilling Co., certify the above well log to be true to the best of my knowledge.

*Granville E. Canaday Jr.*  
Granville E. Canaday Jr.  
CANADAY DRILLING COMPANY

Subscribed and sworn to before me, a notary public in and for Sedgwick County, Kansas the 14th day of April, 1962.

*Theresa M. Lawler*

My Commission expires 1-2-66.