


STATE OF KANSAS
STATE CORPORATION COMMISSION

Give All Information Completely
Make Required Affidavit
Mail or Deliver Report to:
Conservation Division
State Corporation Commission
800 Bitting Building
Wichita, Kansas

WELL PLUGGING RECORD

Graham County, Sec. 32 Twp. 8 Rge. 21 ~~W~~ W (W)
Location as "NE/CNW $\frac{1}{4}$ /SW $\frac{1}{4}$ " or footage from lines SW NW
Lease Owner Nadel and Gussman
Lease Name Green Well No. 1
Office Address P. O. Box 309, Tulsa, Oklahoma
Character of Well (completed as Oil, Gas or Dry Hole) Dry
Date well completed 11-13-51
Application for plugging filed 11-13-51
Application for plugging approved 11-13-51
Plugging commenced 11-13-51
Plugging completed 11-13-51
Reason for abandonment of well or producing formation Dry

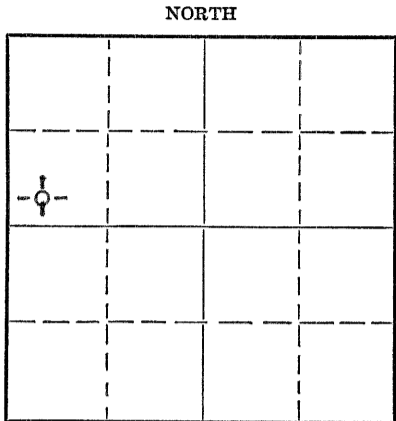

Locate well correctly on above
Section Plat

If a producing well is abandoned, date of last production 19
Was permission obtained from the Conservation Division or its agents before plugging was commenced? Yes

Name of Conservation Agent who supervised plugging of this well Eldon Petty
Producing formation _____ Depth to top _____ Bottom _____ Total Depth of Well 3782 Feet
Show depth and thickness of all water, oil and gas formations.

OIL, GAS OR WATER RECORDS

CASING RECORD

Formation	Content	From	To	Size	Put In	Pulled Out
				8-5/8	169'	None

Describe in detail the manner in which the well was plugged, indicating where the mud fluid was placed and the method or methods used in introducing it into the hole. If cement or other plugs were used, state the character of same and depth placed, from _____ feet to _____ feet for each plug set.

Hole filled with heavy mud from 3782 to 160' - set plug and cemented with 15 sacks cement, filled hole to 40 feet and set plug with 10 sacks cement

NOV 20 1951
DIVISION

(If additional description is necessary, use BACK of this sheet)

Correspondence regarding this well should be addressed to Nadel and Gussman
Address P. O. Box 309, Tulsa, Oklahoma

STATE OF KANSAS, COUNTY OF SEDGWICK, ss.
L. C. Hey (employee of owner) ~~or operator~~

being first duly sworn on oath, says: That I have knowledge of the facts, statements, and matters herein contained and the log of the above-described well as filed and that the same are true and correct. So help me God.

(Signature) L. C. Hey
703 Union Natl Bk Bldg. Wichita, Kans.
(Address)

SUBSCRIBED AND SWORN to before me this 16th day of November 1951
Glenn Bond
Notary Public.

My commission expires Nov. 3, 1952

PLUGGING
FILE sec 32 Twp 8 R 21W
BOOK PAGE 124 LINE 32

NOV 20, 1951

WELL LOG

NADEL AND GUSSMAN

GREEN No. 1

SW SW NW 32-8S-21W
Graham County, Kansas

Comm: 11-2-51
Comp: 11-12-51

Casing: 8-5/8" 169' w/140 sax

<u>Formation</u>	<u>Depth</u>	<u>Geological Tops</u>	
Shale and sand	169		
Shale	225		
Shale, shells and sand	1260		
Sand	1490	Heebner Shale	3380
Shale and shells	1555	Toronto Lime	3401
Shale, red bed, shells	1740	Lensing-Kansas City	3419
Anhydrite	1775	Base Kansas City	3627
Shale and shells	2085	Conglomerate	3750
Broken Lime	2370	Arbuckle	3766
Lime	2455	T.D.	3782
Lime and shale	3420		
Lime	3659		
Lime and Conglomerate	3707		
Conglomerate	3737		
Lime	3762		
Lime and Conglomerate	3766		
Arbuckle	3782		

STATE OF KANSAS)
) SS:
COUNTY OF SEDGWICK)

FILED
FILE SEC 32 T 8 R 21W
BOOK PAGE 124 LINE 32

L. C. Hay, of lawful age, deposes and states that the above formations and depths are correct as taken from the daily drilling log of the No. 1 Green in the SW SW NW 32-8S-21W, Graham County, Kansas.

Subscribed and sworn to before me this 16th day of November, 1951.
L. C. Hay

Nov 20, 1951 *Paula Babb*

Notary Public