


STATE OF KANSAS
STATE CORPORATION COMMISSION
CONSERVATION DIVISION
P. O. BOX 17027
WICHITA, KANSAS 67217

FORM CP-4

WELL PLUGGING RECORD

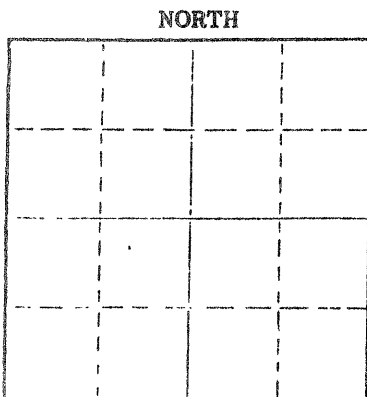

Locate well correctly on above
Section Plat

Graham County. Sec. 33 Twp 8S Rge. 21 (X) (W)
Location as "NE/CNW&SW&" or footage from lines. C W/2 SE/4 NW/4
Lease Owner J. COPELAND LANDES
Lease Name FOUNTAIN Well No. 1
Office Address 416 Union Center, Wichita, Kansas 67202
Character of Well (completed as Oil, Gas or Dry Hole) Oil
Date well completed December 11 1970
Application for plugging filed September 5 1974
Application for plugging approved September 19 1974
Plugging commenced September 19 1974
Plugging completed September 19 1974
Reason for abandonment of well or producing formation non-commercial
If a producing well is abandoned, date of last production January 1972
Was permission obtained from the Conservation Division or its agents before plugging was commenced? yes

Name of Conservation Agent who supervised plugging of this well Du b Sellers
Producing formation _____ Depth to top _____ Bottom _____ Total Depth of Well 3734 feet
Show depth and thickness of all water, oil and gas formations.

OIL, GAS OR WATER RECORDS

CASING RECORD

FORMATION	CONTENT	FROM	TO	SIZE	PUT IN	PULLED OUT

Describe in detail the manner in which the well was plugged, indicating where the mud fluid was placed and the method or methods used in introducing it into the hole. If cement or other plugs were used, state the character of same and depth placed, from _____ feet to _____ feet for each plug set.

Used 20 gel and 90 cement.

(If additional description is necessary, use BACK of this sheet)
Name of Plugging Contractor Allied Cementing Co., Inc. Russell, Kansas
Address _____

STATE OF KANSAS COUNTY OF SEDGWICK
J. Copeland Landes, ss.

(employee of owner) or (owner or operator) of the above-described well, being first duly sworn on oath, says: That I have knowledge of the facts, statements, and matters herein contained and the log of the above-described well as filed and that the same are true and correct. So help me God.


(Signature) J. Copeland Landes
1201 N. Crestway (Address) 1975

Subscribed and sworn to before me this 19th day of June

July 27, 1975.

My commission expires _____

Wilma Riller, Notary Public.

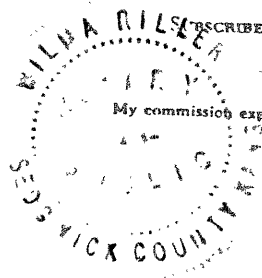

DRILLER'S LOG

COMPANY: Landes Exploration Co., 416 Union Center Bldg., Wichita, Ks. 67202
 CONTRACTOR: Hellar Drilling Company, Inc., Wichita, Kansas 67202
 LEASE: #1 Fountain
 LOCATION: W/2 SE NW 33-8S-21W, Graham County, Kansas
 COMMENCED: November 18, 1970
 COMPLETED: December 11, 1970
 CASING: Set 8 5/8" Surface Casing @ 214'/110 sacks cement
 Set 4 1/2" Casing @ 3729'/600 sacks cement

0-3	Top Soil
3-42	Clay
42-178	Shale
178-194	Sand Rock
194-1075	Shale
1075-1220	Shale & Sand
1220-1430	Sand
1430-1585	Shale & Shells
1585-1697	Shale & Red Bed
1697-1736	Anhydrite
1736-2000	Shale & Red Bed
2000-2255	Shale & Shells & Lime
2255-2440	Shale & Lime
2440-3395	Lime & Shale
3395-3700	Lime
3700-3727	Arbuckle
3727-3734	Lime
3734	Rotary Total Depth

RECEIVED
 STATE CORPORATION COMMISSION
 SEP 9 1974
 SEP 9 1974
 CONSERVATION DIVISION
 Wichita, Kansas

STATE OF KANSAS)
) SS
 COUNTY OF SEDGWICK)

I, D. L. Hellar, do hereby certify that the above and foregoing is a true and correct copy of the log of the #1 Fountain, located in W/2 SE NW 33-8S-21W, Graham County, Kansas, as reflected by the files of the Hellar Drilling Company, Inc.

HELLAR DRILLING COMPANY, INC.

By _____
 President - D. L. Hellar

Subscribed and sworn to before me, a Notary Public, in and for Sedgwick County, Kansas, this 14th day of December, 1970.

 Notary Public - Catherine Darcey

My Commission Expires: March 25, 1972.

