


STATE OF KANSAS
STATE CORPORATION COMMISSION

15-065-63350-00-00

WELL PLUGGING RECORD

Give All Information Completely
Make Required Affidavit
Mail or Deliver Report to:
Conservation Division
State Corporation Commission
211 No. Broadway
Wichita, Kansas

NORTH

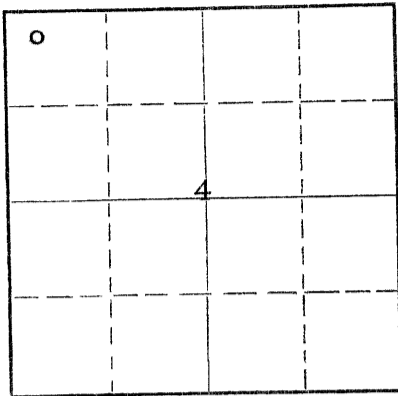

Locate well correctly on above
Section Plat

Location as "NE/CNW%SW%" or footage from lines Graham County. Sec. 4 Twp. 8S Rge. 22W(E) (W)
Lease Owner Murfin Drilling Co. & Morris Sitrin
Lease Name Harrison Well No. 1
Office Address 617 Union Center - Wichita, Kansas
Character of Well (completed as Oil, Gas or Dry Hole) _____
Date well completed 3-5 19 52
Application for plugging filed 2-14 19 57
Application for plugging approved 2-15 19 57
Plugging commenced 2-27 19 57
Plugging completed 3-9 19 57
Reason for abandonment of well or producing formation dry
If a producing well is abandoned, date of last production 2-21 19 57
Was permission obtained from the Conservation Division or its agents before plugging was commenced? yes

Name of Conservation Agent who supervised plugging of this well Eldon Petty
Producing formation Kansas City Depth to top 3411 Bottom _____ Total Depth of Well 3751 Feet
Show depth and thickness of all water, oil and gas formations.

OIL, GAS OR WATER RECORDS

CASING RECORD

FORMATION	CONTENT	FRDM	TD	SIZE	PUT IN	PULLED OUT
				8 5/8	170	none
				7"	3743	1635.95'

Describe in detail the manner in which the well was plugged, indicating where the mud fluid was placed and the method or methods used in introducing it into the hole. If cement or other plugs were used, state the character of same and depth placed, from _____ feet to _____ feet for each plug set.

Plug back with sand to 3470, dump 5 sx. cement.
Pull 7" to 1200' mix & pump in 40 sx. gel mud.
Pull 7" to 750' mix & pump in 40 sx. cement.
Mud to 25' set 5' rock bridge, dump 10 sx. cement to base cellar.

(If additional description is necessary, use BACK of this sheet)

Name of Plugging Contractor Ace Pipe Pulling Co.
Address Great Bend, Kansas

STATE OF Kansas, COUNTY OF Sedgwick, ss.
W. R. Murfin (employee of owner) or (owner or operator) of the above-described well, being first duly sworn on oath, says: That I have knowledge of the facts, statements, and matters herein contained and the log of the above-described well as filed and that the same are true and correct. So help me God.

(Signature) W R Murfin
(Address) _____

SUBSCRIBED AND SWORN TO before me this 20 day of March, 19 57.

My commission expires 6-13-59.

Betty Spriggs
Notary Public.
RECEIVED
STATE CORPORATION COMMISSION
MAR 22 1957
CONSERVATION DIVISION
Wichita, Kansas

PLUGGING
FILE SEC _____ T. _____ R. _____
BOOK PAGE _____ LI _____

WELL LOG


15-065-03350-00-00

COMPANY Murfin & Sitrin
FARM Harrison NO. 1

SEC. 4 T. 8 R. 22W
LOC. NW NW NW

TOTAL DEPTH 3751
COMM. 2-22-52 COMP. 3-5-52
SHOT OR TREATED
CONTRACTOR Murfin Drilling Co.
ISSUED

COUNTY Graham
KANSAS

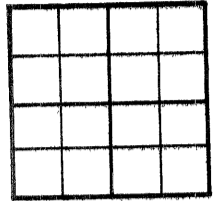

ELEVATION 2174 DF

PRODUCTION

CASING

20 10 170
15 8
12 6
13 5 3743

FIGURES INDICATE BOTTOM OF FORMATIONS

45 Shale
55 Big gravel
164 shale - shells
900 shale
1140 lime-shale
1325 shale-shells
1550 sand-shale
1655 shale-red bed
1800 red bed
1834 Anhydrite
2045 shale
2205 shale-lime
2355 shale-shells
2445 lime-shale
2545 brkn. lime
3255 shale-lime
3705 lime
3730 shale-lime
3742 Cong.
3751 Arb.

Tops

Anhydrite 1800
Topeka 3162
Heebner 3374
Toronto 3396
Lans. 3411
Base K. C. 3614
Arb. 3742
RTD 3751

RECEIVED
STATE CORPORATION COMMISSION

2-15-57

State of Kansas }
County of Sedgwick } SS:

I, W. R. Murfin of the Murfin Drilling Company

upon oath state that the above and foregoing is a true and correct copy of the log of the Harrison #1 well.

PLUGGING
SEC. 4 T. 8 R. 22W
PAGE 141 LINE 1

Subscribed and sworn to before me this 23rd day of Feb 19 57
April 19 52

W R Murfin

My Commission Expires: 6-13-59

Betty Spriggs
NOTARY PUBLIC