

15-005-21144-00-06


STATE OF KANSAS  
STATE CORPORATION COMMISSION

WELL PLUGGING RECORD

Give All Information Completely  
Make Required Affidavit  
Mail or Deliver Report to  
Conservation Division  
State Corporation Comm.  
245 North Water  
Wichita, KS 67202

Graham County, Sec. 4 Twp. 8S Rge. 22W E/W  
Location as "NE/CNW<sup>1</sup>/SW<sup>1</sup>" or footage from lines  
C E/2 SW SE

Lease Owner Tomlinson Oil Company  
Lease Name ~~CHALFRONT~~ Chalfrant Well No. 1  
Office Address 200 W. Douglas, Suite 1030, Wichita KS  
Character of Well (Completed as Oil, Gas or Dry Hole)  
Dry Hole

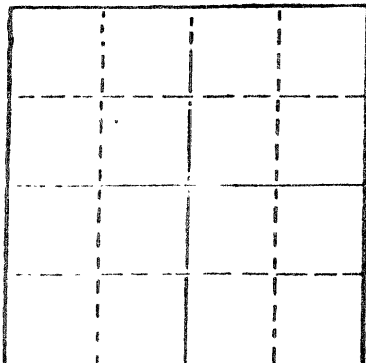

Locate well correctly on above  
Section Plot

Date Well completed July 23 19 79  
Application for plugging filed (verbally) July 23 1979  
Application for plugging approved (verbally) July 23 19 79  
Plugging commenced July 23 19 79  
Plugging completed July 23 19 79  
Reason for abandonment of well or producing formation  
No commercial quantity of oil or gas encountered  
If a producing well is abandoned, date of last production 19

Was permission obtained from the Conservation Division or  
its agents before plugging was commenced? Yes

Name of Conservation Agent who supervised plugging of this well Gilbert Balthazor  
Producing formation \_\_\_\_\_ Depth to top \_\_\_\_\_ Bottom \_\_\_\_\_ Total Depth of Well 3545'  
Show depth and thickness of all water, oil and gas formations.

OIL, GAS OR WATER RECORDS

CASING RECORD

FORMATION	CONTENT	FROM	TO	SIZE	PUT IN	PULLED OUT

Describe in detail the manner in which the well was plugged, indicating where the mud fluid  
was placed and the method or methods used in introducing it into the hold. If cement or other  
plugs were used, state the character of same and depth placed, from \_\_\_\_\_ feet to  
\_\_\_\_\_ feet for each plug set.

T.D. 3545'  
Set 1st plug at 750' with 70 sacks  
2nd plug at 240' with 20 sacks  
3rd plug at 40' solid bridge with 10 sacks  
rathole with 5 sacks.  
Cemented with 50/50 posmix, 6% gel.  
Plug was down at 7:30 p.m., 07-23-79.

RECEIVED  
STATE CORPORATION COMMISSION  
AUG - 2 1979

(If additional description is necessary, use BACK of this sheet)

Name of Plugging Contractor Abercrombie Drilling, Inc.

STATE OF Kansas COUNTY OF Sedgwick  
Jack L. Partridge, Asst. Sec.-Treas. (employee of owner) or (owner or operator)  
of the above-described well, being first duly sworn on oath, says: That I have knowledge of  
the facts, statements, and matters herein contained and the log of the above-described well  
as filed and that the same are true and correct. So help me God.

(Signature) Jack L. Partridge  
801 Union Center, Wichita, Kansas 67202  
(Address)

SUBSCRIBED AND SWORN TO before me this 31st day of July, 19 79



My commission expires 8-21-82

Sherrie L. Brooks  
Notary Public.

15-065-21144-00-00

CONTRACTOR'S WELL LOG

OPERATOR:	Tomlinson Oil Company
CONTRACTOR:	Abercrombie Drilling, Inc.
WELL NAME:	<del>Chalfront</del> #1
LOCATION:	C E/2 SW SE, Section 4-8S-22W Graham County, Kansas
SPUD DATE:	July 17, 1979
COMPLETION DATE:	July 23, 1979

Chalfant  
kcc  
ZAP

0	242	Clay, sand and shale
242	1744	Shale and sand
1744	1773	Anhydrite
1773	1779	Shale and sand
1779	2216	Shale
2216	2765	Lime and shale
2765	2966	Shale
2966	3070	Lime and shale
3070	3272	Shale and lime
3272	3380	Lime and shale
3380	3545	Lime
	3545	Rotary Total Depth

Spud hole at 4:30 p.m., July 17, 1979. Drilled 242' of 12 1/4" hole. Ran 5 joints of 8-5/8" new 24# casing. Set at 241.25' with 180 sacks of 60/40 posmix, 3% Ca.Cl., 2% gel. Cement did circulate. Plug was down at 11:00 p.m., July 17, 1979.

T.D. 3545'. Set 1st plug at 750' with 70 sacks, 2nd plug at 240' with 20 sacks, 3rd plug at 40' solid bridge with 10 sacks, rathole with 5 sacks. Cemented with 50/50 posmix, 6% gel. Plug was down at 7:30 p.m., July 23, 1979.

SAMPLE TOPS:

Anhydrite 1744'  
B/Anhydrite 1773'

RECEIVED  
STATE CORPORATION COMMISSION

AUG - 2 1979

STATE OF KANSAS )  
) ss  
COUNTY OF SEDGWICK )

CONSERVATION DIVISION  
Wichita, Kansas

8-2-79

Jack L. Partridge, Assistant Secretary-Treasurer of Abercrombie Drilling, Inc., does hereby state that the above and foregoing is a true and correct copy of the log of the Chalfront #1, C E/2 SW SE, Section 4-8S-22W, Graham County, Kansas.

ABERCROMBIE DRILLING, INC.

BY Jack L. Partridge  
Jack L. Partridge  
Assistant Secretary-Treasurer

Subscribed and sworn to before me, a Notary Public, in and for the county and state aforesaid, as of this 31st day of July, 1979.



Sherrie L. Brooks  
Sherrie Brooks, Notary Public

My commission expires 8-21-82.