


STATE OF KANSAS
STATE CORPORATION COMMISSION
CONSERVATION DIVISION
P. O. BOX 17027
WICHITA, KANSAS 67217

FORM CP-4

WELL PLUGGING RECORD

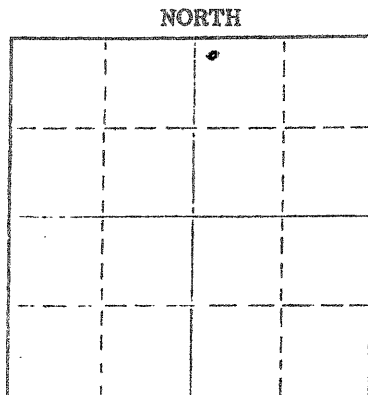

Locate well correctly on above
Section Plat

Graham County. Sec. 5 Twp. 8S Rge. 22 (X) (W)
Location as "NE/CNW/SW" or footage from lines NW NW NE
Lease Owner Andover Oil Company
Lease Name Dunwoody Well No. 2
Office Address 912 Philtower Bldg, Tulsa, Oklahoma 74103
Character of Well (completed as Oil, Gas or Dry Hole) oil
Date well completed 1975
Application for plugging filed December 10 1975
Application for plugging approved December 10 1975
Plugging commenced December 10 1975
Plugging completed December 10 1975
Reason for abandonment of well or producing formation depleted

If a producing well is abandoned, date of last production 1975
Was permission obtained from the Conservation Division or its agents before plugging was commenced? yes

Name of Conservation Agent who supervised plugging of this well Gilbert Balthazor
Producing formation Lansing Depth to top 3448 Bottom 3507 Total Depth of Well 3780 Feet
Show depth and thickness of all water, oil and gas formations.

OIL, GAS OR WATER RECORDS

CASING RECORD

FORMATION	CONTENT	FROM	TO	SIZE	PUT IN	PULLED OUT
Lansing	unknown	--	--	8-5/8"	227	none
				5-1/2	3602	none

Describe in detail the manner in which the well was plugged, indicating where the mud fluid was placed and the method or methods used in introducing it into the hole. If cement or other plugs were used, state the character of same and depth placed, from feet to feet for each plug set.

Cement was pumped via 5-1/2 x 8-5/8 casing annulus using 35 sks regular cement from surface to 233'.

Cement was pumped via 5-1/2 casing using 65 sks regular cement from surface to 588'

Name of Plugging Contractor Allied Cementers (If additional description is necessary, use BACK of this sheet)
Address Plainville, Kansas

Dec 23, 1975

STATE OF Oklahoma COUNTY OF Tulsa
Bobby Young, ss.

(employee of owner) or (owner or operator) of the above-described well, being first duly sworn on oath, says: That I have knowledge of the facts, statements, and matters herein contained and the log of the above-described well as filed and that the same are true and correct. So help me God.

(Signature)

912 Philtower Building, Tulsa, Ok 74103

Subscribed and sworn to before me this 19 day of December 1975

My commission expires May, 15 1976

Notary Public.