


Give All Information Completely
Make Required Affidavit
Mail or Deliver Report to:
Conservation Division
State Corporation Commission
800 Bittling Building
Wichita, Kansas

15-069-00246-00-00
WELL PLUGGING RECORD

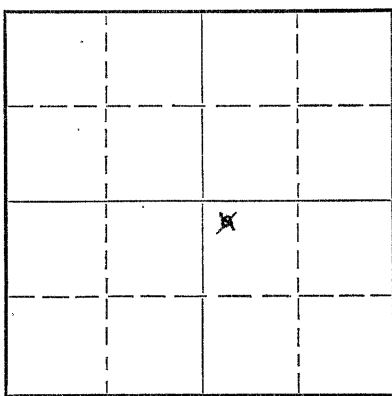

Locate well correctly on above Section Plat

Graham County, Sec. 20 Twp 8S Rge. 22 (E) W (W)

Location as "NE/CNW $\frac{1}{4}$ SW $\frac{1}{4}$ " or footage from lines NW NW SE
Lease Owner DEEP ROCK OIL CORPORATION
Lease Name Moore Well No. 2
Office Address Box #1051, Tulsa, Oklahoma
Character of Well (completed as Oil, Gas or Dry Hole) Dry Hole
Date well completed November 8 19 51
Application for plugging filed November 9 19 51
Application for plugging approved 19
Plugging commenced November 8 19 51
Plugging completed November 9 19 51
Reason for abandonment of well or producing formation
If a producing well is abandoned, date of last production 19
Was permission obtained from the Conservation Division or its agents before plugging was commenced? Yes

Name of Conservation Agent who supervised plugging of this well Mr. Eldon Petty
Producing formation Arbuckle Depth to top 3891' Bottom 3925' Total Depth of Well 3925' Feet
Show depth and thickness of all water, oil and gas formations.

OIL, GAS OR WATER RECORDS

CASING RECORD

Formation	Content	From	To	Size	Put In	Pulled Out
				8-5/8"	136'	None

Describe in detail the manner in which the well was plugged, indicating where the mud fluid was placed and the method or methods used in introducing it into the hole. If cement or other plugs were used, state the character of same and depth placed, from _____ feet to _____ feet for each plug set.

Put in 18 sacks cement from 3925' to 3855', filled up with heavy mud to 367'. Put in 75 sacks cement filled from 3670' to 3427'. Filled with heavy mud to 130'. Set bridging plug and put in 20 sacks cement, filled up to 70'. Filled with heavy mud to 40'. Set plug and put in 10 sacks cement, filled to top of hole and into cellar.

RECEIVED
STATE CORPORATION COMMISSION
DEC-1-1951
CONSERVATION DIVISION
Wichita, Kansas

12-1-51

(If additional description is necessary, use BACK of this sheet)
Name of Plugging Contractor Barnett Drilling Company
Address Wichita, Kansas

STATE OF Kansas, COUNTY OF Reno, ss.
Jack Smith (employee of owner) or (owner or operator) of the above-described well, being first duly sworn on oath, says: That I have knowledge of the facts, statements, and matters herein contained and the log of the above-described well as filed and that the same are true and correct. So help me God.

(Signature) *Jack Smith*
Kansas Production Superintendent
(Address)

SUBSCRIBED AND SWORN to before me this 15th day of Nov 1951
C. E. Eagle
Notary Public.

My commission expires _____ 23-8390-s 6-51-20M

PLUGGING
NOV SEC 20 T 8 R 22
PAGE 24 LINE 35

15-065-00246-00-00

BARNETT DRILLING, INC.
 LOG OF MOORE WELL NO. 2.
NW $\frac{1}{4}$ NW $\frac{1}{4}$ SE $\frac{1}{2}$, SECTION 20-8S-22W, GRAHAM COUNTY, KANSAS

DATE COMMENCED: October 22, 1951

DATE COMPLETED: November 18, 1951

Formation	From	To	Remarks
Surface Clay	0	22'	Set 8-5/8" Surface Pipe at 136 feet; cemented with 125 sacks.
Sand	22	65'	
Shale	65	136'	
Shale	136	620'	
Shale, Shells and Sand	620	1115'	
Shale and Sand	1115	1230'	
Shale	1230	1350'	
Sand	1350	1550'	
Shale and Shells	1550	1790'	
Anhydrite	1790	1830'	
Shale and Shells	1830	2450'	
Shale and Lime	2450	2535'	
Shale and Shells	2535	2600'	
Shale and Lime	2600	2705'	
Lime and Shale	2705	2950'	
Shale and Shells	2950	3040'	
Lime and Shale	3040	3400'	
Lime	3400	3870'	
Chert and Shale	3870	3900'	
Lime and Chert	3900	3925'	
Total Depth		3925'	Dry and Abandoned

CERTIFICATE


I, F. R. Stubblefield, of Barnett Drilling, Inc., hereby certify that to the best of my knowledge and belief, the above is a true and correct log of the Moore Well No. 2, located in the NW $\frac{1}{4}$ NW $\frac{1}{4}$ SE $\frac{1}{2}$ Section 20-8S-22W, Graham County, Kansas.

F. R. Stubblefield

Subscribed and sworn to before me, in and for the County of Sedgwick, State of Kansas, this 12th day of November, 1951.

Adelaide Olivier
 Notary Public

My Commission Expires: May 12, 1955.

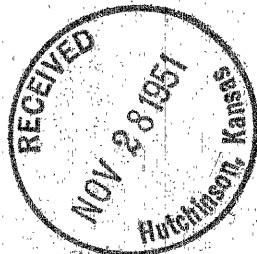

12-1-51

PLUGGING
 FILE SEC 22 T 8 R 21
 BOOK PAGE 104 LINE 35

DEC 7 1951
 CONSERVATION DIVISION
 Wichita, Kansas