


DISTRICT CONSERVATION AGENT'S REPORT

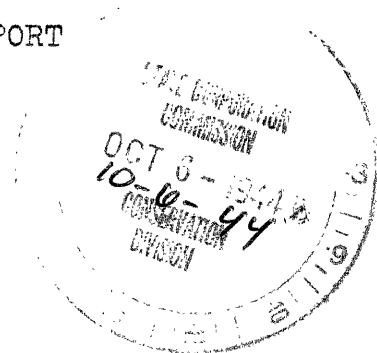

TO:

State Corporation Commission  
Conservation Division  
800 Bitting Building  
Wichita, Kansas

FILE NO. \_\_\_\_\_

LOCATION SW SE 1/4

SEC. 5 TWP. 26 RGE. 2E

Dry Hole  Abandoned Oil Well \_\_\_\_\_ Abandoned Gas Well \_\_\_\_\_

I have today completed supervision of plugging of:

Well No. 1 Lease Broers

Operator Nelson Dry Co Address Wichita

Field  County Red Queen

Total Depth 2007 Feet.

(Describe briefly the manner in which the well was plugged)

15 cu cement in bottom

Mud to 148'

15 cu cement to 139' Surface pipe set at 148'

Mud to 10'

10 cu cement to surface & base of cellar

*W. L. Lacey*

District Conservation Agent

Date Oct 4, 1944

BITTING  
526 2E  
134 18