



Give All Information Completely
Make Required Affidavit
Mail or Deliver Report to:
Conservation Division
State Corporation Commission
211 No. Broadway
Wichita, Kansas

WELL PLUGGING RECORD

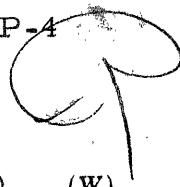

Sedgwick County, Sec. 5 Twp. 26S Rge. 2 (E) (W)
Location as "NE/CNW&SW&" or footage from lines NE NE SE
Lease Owner Emil B. Kucera
Lease Name Korber B Well No. 1
Office Address 512 Orpheum Building, Wichita, Kansas
Character of Well (completed as Oil, Gas or Dry Hole) Dry Hole
Date well completed December 8 19 62
Application for plugging filed December 8 19 62
Application for plugging approved December 8 19 62
Plugging commenced December 8 19 62
Plugging completed December 8 19 62
Reason for abandonment of well or producing formation No commercial shows of oil and/or gas.

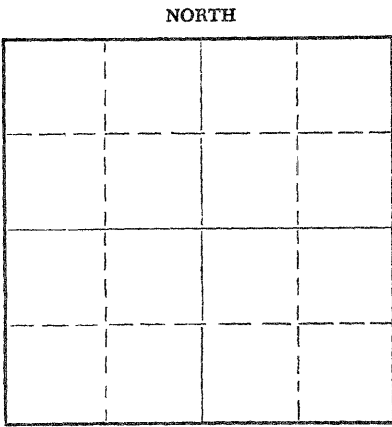

Locate well correctly on above Section Plat

If a producing well is abandoned, date of last production _____ 19____
Was permission obtained from the Conservation Division or its agents before plugging was commenced? Yes

Name of Conservation Agent who supervised plugging of this well Paul Tewpin
Producing formation None Depth to top _____ Bottom _____ Total Depth of Well 3030 Feet
Show depth and thickness of all water, oil and gas formations.

OIL, GAS OR WATER RECORDS

CASING RECORD

FORMATION	CONTENT	FROM	TO	SIZE	PUT IN	PULLED OUT
None						

Describe in detail the manner in which the well was plugged, indicating where the mud fluid was placed and the method or methods used in introducing it into the hole. If cement or other plugs were used, state the character of same and depth placed, from _____ feet to _____ feet for each plug set.

Mudded with heavy mud to 160 feet. Set plug.
Put 20 sacks cement on plug. Mudded with heavy mud to 30 feet.
Put 8 sacks cement on top of plug. Cut off surface below plow depth and welded cap on top. Put 2 sacks cement in rat hole.

RECEIVED
STATE CORPORATION COMMISSION
DEC 12 1962
12-12-62
CONSERVATION DIVISION
Wichita, Kansas

(If additional description is necessary, use BACK of this sheet)

Name of Plugging Contractor Canaday Drilling Company
Address 6427 East Kellogg, Wichita, Kansas

STATE OF Kansas, COUNTY OF Sedgwick, ss.
Granville E. Canaday, Jr. (employee of owner) or (owner or operator) of the above-described well, being first duly sworn on oath, says: That I have knowledge of the facts, statements, and matters herein contained and the log of the above-described well as filed and that the same are true and correct. So help me God.

(Signature) Granville E. Canaday, Jr.
6427 East Kellogg, Wichita, Kansas
(Address)

SUBSCRIBED AND SWORN TO before me this 10th day of December, 19 62

My commission expires August 5, 1965
Mary E. Lacey Notary Public.



WELL LOG

COMPANY: Emil B. Kucera
512 Orpheum Building
Wichita, Kansas

COMMENCED: December 1, 1962

COMPLETED: December 8, 1962

LEASE: Korber B #1

TOTAL DEPTH: 3030 feet

LOCATION: NE NE SE Sec. 5-26S-2E
Sedgwick County, Kansas

CONTRACTOR: Canaday Drilling Company
6427 East Kellogg
Wichita, Kansas

CASING: 141 feet of 8 5/8" with 120 sacks common w/2% C.C.

FIGURES INDICATE BOTTOM OF FORMATION

130	Lime & Shale	1955	Lime & Shale
215	Lime	2230	Shale & Lime Strks
457	Lime & Shale	2680	Lime & Shale
775	Shale & Shells	2810	Shale
1075	Shale	2937	Shale - Lime
1390	Shale - Lime	2980	Sand & Shale
1680	Shale	3030	Mississippi
1845	Shale & Lime	3030	T.D.

I, Granville E. Canaday, Jr. of
CANADAY DRILLING COMPANY certify
the above Well Log to be true to
the best of my knowledge.

Granville E. Canaday, Jr.
Granville E. Canaday, Jr.

Subscribed and sworn to before me, a
Notary Public in and for Sedgwick County,
Kansas this 10th day of December, 1962.

Mary E. Lacey
My Commission expires August 5, 1965

RECEIVED
STATE CORPORATION COMMISSION

DEC 12 1962

CONSERVATION DIVISION
Wichita, Kansas