


STATE OF KANSAS  
STATE CORPORATION COMMISSION

WELL PLUGGING RECORD

Give All Information Completely  
Make Required Affidavit  
Mail or Deliver Report to:  
Conservation Division  
State Corporation Commission  
800 Bitting Building  
Wichita, Kansas

Sedgwick County. Sec. 5 Twp. 26S Rge. 2 (E) (W)  
Location as "NE/CNW $\frac{1}{4}$ SW $\frac{1}{4}$ " or footage from lines C. S./2 SE SW  
Lease Owner John P. Gaty  
Lease Name Broers Well No. 3  
Office Address 11 Cypress Drive  
Character of Well (completed as Oil, Gas or Dry Hole) Oil  
Date well completed April 5, 19 50  
Application for plugging filed March 27, 19 52  
Application for plugging approved March 28, 19 52  
Plugging commenced April 1, 19 52  
Plugging completed April 1, 19 52  
Reason for abandonment of well or producing formation Dry

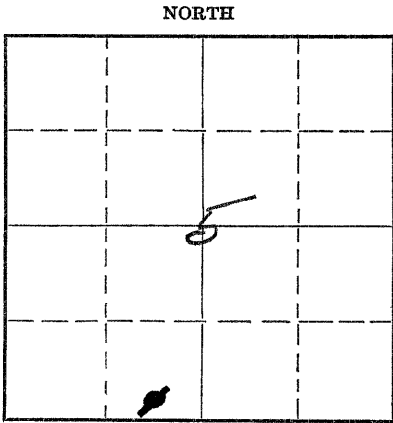

Locate well correctly on above  
Section Plat

If a producing well is abandoned, date of last production January, 19 52  
Was permission obtained from the Conservation Division or its agents before plugging was commenced? Yes

Name of Conservation Agent who supervised plugging of this well D. G. Lilley  
Producing formation Burgess Depth to top Bottom Total Depth of Well 2993 Feet  
Show depth and thickness of all water, oil and gas formations.

OIL, GAS OR WATER RECORDS

CASING RECORD

Formation	Content	From	To	Size	Put In	Pulled Out
				8-5/8	100	
				5-1/2	2993	2873

Describe in detail the manner in which the well was plugged, indicating where the mud fluid was placed and the method or methods used in introducing it into the hole. If cement or other plugs were used, state the character of same and depth placed, from feet to feet for each plug set.

3 Sacks Cement in bottom  
Mudded to 150'  
15' rock bridge with 10 Sacks Cement from 150' to 135'  
Mudded to 20'  
10' rock bridge with 5 sacks cement in Cellar

(If additional description is necessary, use BACK of this sheet)

Correspondence regarding this well should be addressed to John P. Gaty  
Address 11 Cypress Dr.  
Wichita, Kansas

STATE OF Kansas, COUNTY OF Sedgwick, ss.  
Wm. Vallandingham (employee of owner) or (owner or operator) of the above-described well,  
being first duly sworn on oath, says: That I have knowledge of the facts, statements, and matters herein contained and the log of the above-described well as filed and that the same are true and correct. So help me God.

(Signature) \* *Wm. Vallandingham*  
547 No. Green, Wichita, Kansas  
(Address)

SUBSCRIBED AND SWORN to before me this 4th day of April, 19 52

My commission expires December 12, 1955  
*J. Arnold Sewell*  
Notary Public.

PLUGGING  
FILE SEC 51 26 26  
BOOK PAGE 4 LINE 17

4-5-52

WELL LOG - Broers #3

OPERATOR: Mr. J. P. Gaty  
c/o Beach Aircraft Corp.  
Wichita, Kansas

LOCATION: C. S/2 SE/4 SW/4  
Section 5, Township 26  
South, Range 2 East,  
Sedgwick County, Kansas

CONTRACTOR: Morrison Drilling Company, Inc.  
P. O. Drawer 712  
El Dorado, Kansas

PRODUCTION: \_\_\_\_\_

Farm: Broers Well No. 3

Date Commenced: March 30, 1950

Date Completed: April 5, 1950

Total Depth: 2987 1/2 feet

<u>From</u>	<u>To</u>	<u>Formation</u>	<u>From</u>	<u>To</u>	<u>Formation</u>
97	115	Cement	2533	2542	Lime
115	230	Lime & Shale Brks.	2542	2680	Lime
230	300	Lime	2680	2692	Lime-sandy
300	350	Shale	2692	2780	Shale
350	440	Lime	2780	2802	Lime
440	520	Shale	2802	2820	Shale
520	550	Lime	2820	2825	Lime
550	580	Shale	2825	2831	Shale & Shells
580	610	Lime	2831	2848	Lime
610	620	Red Bed	2848	2905	Lime-Shale Brks.
620	690	Shale	2905	2940	Lime
690	710	Lime	2940	2981	Shale-Lime Strks.
710	780	Lime-broken	2981	2987 1/2	Lime
780	795	Shale	2987 1/2		Total Depth.
795	860	Lime			
860	945	Lime & Shale Brks.			
945	1080	Shale & Shells			
1080	1085	Red Bed			
1085	1100	Shale			
1100	1260	Shale and Lime Strks.			
1260	1310	Lime			
1310	1360	Shale			
1360	1410	Lime-broken			
1410	1500	Lime-sandy			
1500	1535	Shale			
1535	1630	Lime & Shale Strks.			
1630	1650	Shale			
1650	1695	Shale Sandy			
1695	1735	Lime			
1735	1765	Shale			
1765	1860	Shale & Shells			
1860	1965	Lime			
1965	1995	Shale & Lime Strks.			
1995	2040	Lime			
2040	2080	Shale-sandy			
2080	2090	Shale			
2090	2165	Shale-sandy			
2165	2200	Lime			
2200	2225	Shale			
2225	2260	Lime			
2260	2275	Shale			
2275	2310	Lime			
2310	2330	Lime-broken			
2330	2410	Lime			
2410	2415	Shale			
2415	2460	Lime			
2460	2533	Shale			


Cable Tool Log

2988 Top of Burgess Sand  
2988 1/2 Free Oil  
2993 Sand - T. D.

5 26 2c

4 17

I hereby certify that the foregoing is a true and correct copy of the Well Log for the Broers #3 Well drilled for Mr. J. P. Gaty and completed April 5, 1930.

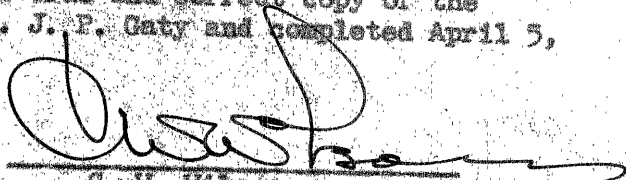

C. W. Wilson  
Secretary-Treasurer

STATE OF KANSAS

COUNTY OF BUTLER

} ss.

SUBSCRIBED AND SWORN TO, Before the undersigned, a Notary Public, in and for the County and State aforesaid this 6th day of April, 1930.



Notary Public

My Commission Expires January 10, 1931.