

15-173-02026-00-00 *R*

STATE OF KANSAS
STATE CORPORATION COMMISSION

Give All Information Completely
Make Required Affidavit
Mail or Deliver Report to:
Conservation Division
State Corporation Commission
211 No. Broadway
Wichita, Kansas

WELL PLUGGING RECORD

SEDGWICK County. Sec. 6 Twp. 26S Rge. 2E (E) (W)

Location as "NE/CNW&SW" or footage from lines SW SW NE

Lease Owner Sam P. Wallingford, Inc.

Lease Name Timmerkamp Well No. 1

Office Address Colorado Derby Bldg., Wichita, Kansas

Character of Well (completed as Oil, Gas or Dry Hole) Dry

Date well completed 3-9 19 62

Application for plugging filed 3-9 19 62

Application for plugging approved 3-9 19 62


Plugging commenced 3-9 19 62

Plugging completed 3-9 19 62

Reason for abandonment of well or producing formation Dry

If a producing well is abandoned, date of last production 19

Was permission obtained from the Conservation Division or its agents before plugging was commenced?

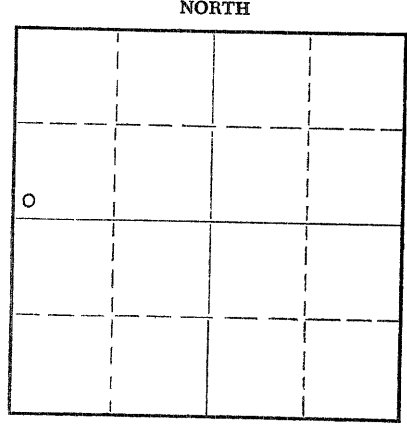

Locate well correctly on above Section Plat

Name of Conservation Agent who supervised plugging of this well Cecil Jones, McPherson, Kansas

Producing formation Depth to top Bottom Total Depth of Well 3517 Feet

Show depth and thickness of all water, oil and gas formations.

OIL, GAS OR WATER RECORDS

CASING RECORD

FORMATION	CONTENT	FROM	TO	SIZE	PUT IN	PULLED OUT

Describe in detail the manner in which the well was plugged, indicating where the mud fluid was placed and the method or methods used in introducing it into the hole. If cement or other plugs were used, state the character of same and depth placed, from feet to feet for each plug set.

Heavy mud to 250 ft.
Bridged plug with 1/4 sack hulls-20 sax cement
Mud to 35'
Plugged with 1/4 sack hulls - 8 sax cement
Plugged rat hole with 2 sax cement

RECEIVED
STATE CORPORATION COMMISSION
MAR 13 1962
3-16-62
CONSERVATION DIVISION
Wichita, Kansas

(If additional description is necessary, use BACK of this sheet)
Name of Plugging Contractor Graves Drilling Company, Inc.
Address Box 332, El Dorado, Kansas

STATE OF Kansas, COUNTY OF Butler, ss.
John C. Graves (employee of owner) or (owner or operator) of the above-described

well, being first duly sworn on oath, says: That I have knowledge of the facts, statements, and matters herein contained and the log of the above-described well as filed and that the same are true and correct. So help me God!

(Signature) John C. Graves
Box 332, El Dorado, Kansas (Address)

SUBSCRIBED AND SWORN TO before me this 14th day of March, 1962

My commission expires Nov. 23, 1963
Marlene Turckel
Notary Public.



SAM P. WALLINGFORD, INC.

#1 TIMMERKAMP

SCC
x1)

Total Depth - 3517'
Contractor - Graves Drilling Co., Inc.
Commenced - 3-1-1962
Completed - 3-9-1962

Section 6-26S-2E
SW SW NE
Sedgwick County, Kansas
8" set @ 204'

<u>FORMATION</u>	<u>DEPTH</u>
Soil	22
Sand	28
Shale	94
Lime	228
Shale & shells	535
Lime	616
Sandy shale	744
Shale	1409
Shale & shells	1996
Lime	2020
Shale	2175
Lime	2202
Shale & shells	2526
Lime	2853
Shale	2943
Sandy shale	2996
Lime	3287
Shale	3364
Lime	3379
Shale	3382
Lime	3404
Sandy shale	3499
Lime	3517 T. D.

STATE OF KANSAS
MAR 1 1962
CONSERVATION DIVISION
WICHITA

I hereby certify the foregoing statements to be true and correct to the best of my knowledge.

GRAVES DRILLING COMPANY, INC.

STATE OF KANSAS)
) SS
COUNTY OF BUTLER)

By John Graves

Subscribed and sworn to before me, a Notary Public, this 14th day of March, 1962.

My commission expires:

Marlene Fairchild
(Notary Public)

Nov. 23, 1963