


Give All Information Completely
Make Required Affidavit
Mail or Deliver Report to:
Conservation Division
State Corporation Commission
211 No. Broadway
Wichita, Kansas

WELL PLUGGING RECORD

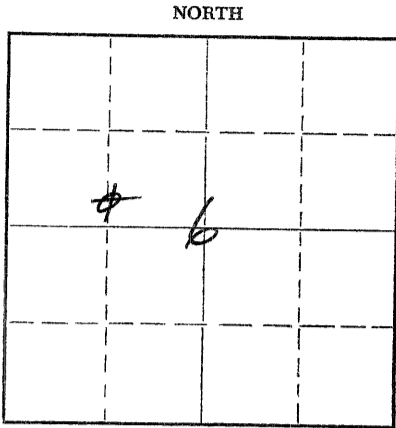

Locate well correctly on above Section Plat

SEDGWICK COUNTY County. Sec. 6 Twp. 26S Rge. ✓ (E) (W)
Location as "NE/CNWSW" or footage from lines CENTER OF S 1/2 OF S 1/2 OF NW
Lease Owner J. P. GATY
Lease Name TIMMERKAMP Well No. B1
Office Address 11 CYPRESS DRIVE WICHITA, KANSAS
Character of Well (completed as Oil, Gas or Dry Hole) DRY HOLE
Date well completed JULY 29
Application for plugging filed 19 57
Application for plugging approved 19
Plugging commenced 7-29-57 19
Plugging completed 7-29-57 19
Reason for abandonment of well or producing formation WORK DRY HOLE

If a producing well is abandoned, date of last production NONE 19
Was permission obtained from the Conservation Division or its agents before plugging was commenced? YES

Name of Conservation Agent who supervised plugging of this well RUAL DURKEE McPHERSON, KANSAS
Producing formation MISSISSIPIAN Depth to top 2991 Bottom 3059 Total Depth of Well 3059 Feet
Show depth and thickness of all water, oil and gas formations.

OIL, GAS OR WATER RECORDS

CASING RECORD

| FORMATION | CONTENT | FROM | TO | SIZE | PUT IN | PULLED OUT |
|----------------|---------|------|----|------|--------|------------|
| <u>NOTHING</u> | | | | | | |
| | | | | | | |
| | | | | | | |
Describe in detail the manner in which the well was plugged, indicating where the mud fluid was placed and the method or methods used in introducing it into the hole. If cement or other plugs were used, state the character of same and depth placed, from 3059 feet to 102 feet for each plug set.

REAL HEAVY MUD PUMPED IN HOLE & CIRCULATED TO TOP OF HOLE.
BRIDGE PLACED @ 160' & HOLE FILLED WITH ROCKS UP TO 102'
25 SACKS OF CEMENT MIXED AND PUT IN HOLE ON TOP OF BRIDGE. HOLE
FILLED WITH HEAVY MUD UP TO 25' OF TOP OF BRIDGE PUT IN UP TO
10' & MIXED 5 SACKS OF CEMENT & FILLED ON UP TO TOP. SURFACE PIPE
CUT OFF 3' UNDER TOP OF GROUND.

(If additional description is necessary, use BACK of this sheet)

Name of Plugging Contractor GLEN DRILLING INC.
Address BOX 547 EL DORADO, KANSAS

STATE OF Kansas COUNTY OF Sedgwick, ss.
Dalton M. Peet (employee of owner) or (owner or operator) of the above-described well, being first duly sworn on oath, says: That I have knowledge of the facts, statements, and matters herein contained and the log of the above-described well as filed and that the same are true and correct. So help me God.

(Signature) x Dalton M. Peet
511 1/2 No. Hillside (Address)

SUBSCRIBED AND SWORN to before me this 1st day of August, 1957

My commission expires December 12, 1959
J. Donald Sewell Notary Public.

RECEIVED
STATE CORPORATION COMMISSION

PLUGGING
FILE SEC 6 T 26 R 2 E
BOOK PAGE 32 LINE 19

AUG 2 1957
8-2-57
CONSERVATION DIVISION

WELL LOG

OPERATOR

J.P. GATY
11 CYPRESS DRIVE
WICHITA, KANSAS

LOCATION:
CENTER OF S HALF
OF S. HALF OF NW
QUARTER 6-26-2 E
SEDGWICK COUNTY,
KANSAS.

CONTRACTOR

GLEN DRILLING, INC.
P.O. Box 547
EL DORADO, KANSAS

WELL NAME:

TIMMERKAMP #B-1

DATE COMM:

JULY 22, 1957

DATE COMP:

JULY 29, 1957

TOTAL DEPTH

3059-ROTARY

| FROM | TO | SOIL |
|------|------|----------------------|
| 0 | 10 | SOIL |
| 10 | 102 | SHALE |
| 102 | 200 | SHALE & SHELLS |
| 200 | 240 | SHALE & LIME |
| 240 | 475 | LIME & SHALE |
| 475 | 715 | SHALE & LIME |
| 715 | 840 | LIME |
| 840 | 915 | SHALE & SHELLS |
| 915 | 1340 | SHALE & SHELLS |
| 1340 | 1560 | SHALE & LIME |
| 1560 | 1775 | SHALE & LIME STREAKS |
| 1775 | 1820 | SHALE & LIME |
| 1820 | 1955 | LIME & SHALE |
| 1955 | 2105 | SHALE & LIME |
| 2105 | 2285 | LIME & SHALE |
| 2285 | 2375 | LIME |
| 2375 | 2435 | LIME |
| 2435 | 2535 | SHALE & LIME |
| 2535 | 2575 | LIME |
| 2575 | 2701 | LIME |
| 2701 | 2735 | LIME & SHALE |
| 2735 | 2830 | SHALE & LIME STREAKS |
| 2830 | 2849 | LIME |
| 2849 | 3010 | SHALE & LIME |
| 3010 | 3012 | MISSISSIPPIAN LIME |
| 3012 | 3039 | CHAT & LIME |
| 3039 | 3059 | SOFT LIME |
| 3059 | | TOTAL DEPTH |

I HEREBY CERTIFY THAT THE FOREGOING IS A TRUE AND CORRECT COPY OF THE WELL LOG FOR THE TIMMERKAMP #B-1 WELL DRILLED FOR ~~MRS~~ J. P. GATY AND COMPLETED JULY 29, 1957.

GLEN DRILLING, INC.

Glen Gaines
GLEN GAINES, PRESIDENT

STATE OF KANSAS) SS
COUNTY OF BUTLER)

SUBSCRIBED AND SWORN TO BEFORE THE UNDERSIGNED A NOTARY PUBLIC IN AND FOR COUNTY AND STATE AFORESAID THIS 29TH DAY OF JULY, 1957.

Alona M. Wentworth
ALONA M. WENTWORTH, NOTARY PUBLIC

MY COMMISSION EXPIRES JUNE 22, 1961

RECEIVED
STATE CORPORATION COMMISSION

AUG 2 1957

PLUGGING
FILE SEC 6 T 26 R 2 E
BOOK PAGE 32 LINE 19

CONSERVATION