
KANSAS CORPORATION COMMISSION OIL & GAS CONSERVATION DIVISION

WELL PLUGGING APPLICATION

Please TYPE Form and File ONE Copy

Form CP-1 September 2003 This Form must be Typed Form must be Signed All blanks must be Filled

API # 15 - 135-22224-00-01	(Identifier Number of this we	dl). This must be listed for wells drilled since 1967; if	f no API # was issued
indicate original spud or completion date			
Wall Coords: PETROLEUM PROPERTY SERVICES, INC		KCC License #: 31142	
Address: 125 N. MARKET, SUITE 1251		(Operator's)	
		Contact Phone: (316) 265 - 335	51
		Sec. 5 Twp. 17 S. R. 25	
ENW- NESW- NW - NE	Spot Location / QQQQ Co	unty: NESS	
	North / South (from ne	parest outside section corner) Line of Section (Not Leas parest outside section corner) Line of Section (Not Leas Water Supply Well	se Line)
Conductor Casing Size:	Set at:	Cemented with:	Sacks
Surface Casing Size: 8-5/8"	Set at: <u>264</u>	Cemented with: 165	Sacks
Production Casing Size: 4-1/2	Set at: 1809	Cemented with: 650	Sacks
List (ALL) Perforations and Bridgeplug Sets: CE Elevation: 2527 (Good Poor	20 PBTD: 1786	Anhydrite Depth: 1885(+642) (Stone Corral Format,	ion)
Proposed Method of Plugging (attach a separate page) Is Well Log attached to this application as required?	Yes No Is ACO-1 fi		
Plugging of this Well will be done in accordance List Name of Company Representative authorized		ne Rules and Regulations of the State Corporation ions: LEON KUHN Phone: (785) 483 - 1559	n Commission.
Address: P O BOX 551		City / State: RUSSELL, KS 67665	
Plugging Contractor: H-D OILFIELD SERVICE		KCC License #: 32970	
	Company Name)	(Contractor's Phone: (785) 398 - 2289	s)
Proposed Date and Hour of Plugging (if known?):	AS SOON AS RIG IS AVA		
Payment of the Plugging Fee (K.A.R. 82-3-118) w Date: 1/21/08 Authorized Operator	ill be guaranteed by Operato or	RE	CEIVED DRATION COMMISSION

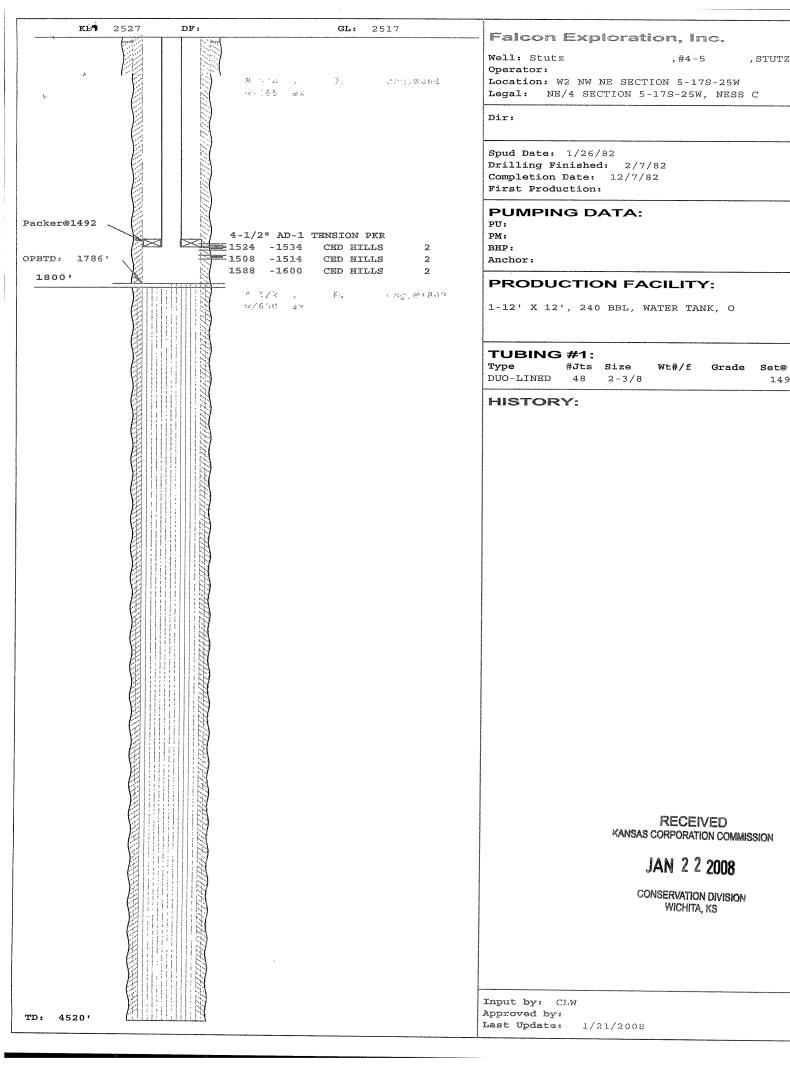

,STUTZ--

1492



Kathleén Sebelius, Governor Thomas E. Wright, Chairman Michael C. Moffet, Commissioner Joseph F. Harkins, Commissioner

TELECOPIER COVER LETTER

**************************************	individual or entity to which it is addressed. It may contain it, or otherwise protected from disclosure under applicable law, e employee or agent responsible for delivering the transmission nation, distribution, copying or use of this transmission or its sion in error, please notify us by telephoning and return the
DATE: 2-8-08	NO CHARGE CHARGE (1.95 per page - INVOICE WILL FOLLOW please pay from received invoice)
TO: ROSANIN FAX COMPANY: Petroleum Property BILLING ADDRESS:	PHONE NO: 265-3354 Services
FROM: DEANNA	PHONE:337-6209
NUMBER OF PAGES: 2 TITLE OF DOC (Including cover sheet) SPECIAL INSTRUCTIONS:	CUMENT CP-

IF YOU DO NOT RECEIVE ALL THE PAGES, PLEASE CALL BACK AS SOON AS POSSIBLE TO 316-337-6200. THE KCC FAX NUMBER IS: 316-337-6211.



Kathleen Sebelius, Governor Thomas E. Wright, Chairman Michael C. Moffet, Commissioner Joseph F. Harkins, Commissioner

NOTICE OF RECEIPT OF WELL PLUGGING APPLICATION (CP-1)

PETROLEUM PROPERTY SERVICES, INC. 125 N MARKET SUITE 1251 WICHITA, KS 67202-1719

February 08, 2008

Re: STUTZ #4-5

API 15-135-22224-00-01

5-17S-25W, 4604 FSL 2427 FEL

NESS COUNTY, KANSAS

Dear Operator:

This letter is to notify you that the Conservation Division has received your plugging proposal, form CP-1, for the above well and has reviewed the proposal for completeness. The central office will now forward your CP-1 to the district office listed below for review of the proposed plugging method. Please contact the district office for approval of your proposed plugging method at least five (5) days before plugging the well, pursuant to K.A.R. 82-3-113(b). If a workover pit will be used during the plugging of the well it must be permitted. A CDP-1 form must be filed and approved prior to the use of the pit in accordance with K.A.R. 82-3-600.

The Conservation Division's review of form CP-1, either in the central or district office, does not include an inquiry into well ownership or the filing operator's legal right to plug the well. This notice in no way constitutes authorization to plug the above well by persons not having legal rights of ownership or interest in the well.

This notice is void after August 6, 2008. The CP-1 filing does not bring the above well into compliance with K.A.R. 82-3-111 with regard to the Commission's temporary abandonment requirements.

Sincerely,

Steve Bond

Sture Bond

Production Department Supervisor

District: #1 210 E Frontview, Suite A Dodge City, KS 67801 (620) 225-8888