

STATE OF KANSAS  
STATE CORPORATION COMMISSION

15-05-21317-00-00

WELL PLUGGING RECORD

Give All Information Completely  
Make Required Affidavit  
Mail or Deliver Report to  
Conservation Division  
State Corporation Comm.  
245 North Water  
Wichita, KS 67202

Graham County, Sec. 32 Twp. 8S Rge. 22 E/W  
Location as "NE/CNW $\frac{1}{4}$ SW $\frac{1}{4}$ " or footage from lines

NE SE NE  
Lease Owner K & E Drilling, Inc.

Lease Name KORB Well No. 1

Office Address 816 Union Center, Wichita, Kansas 67202

Character of Well (Completed as Oil, Gas or Dry Hole)  
Dry Hole

Date Well completed 10-13-1980

Application for plugging filed 10-13-1980

Application for plugging approved 10-13-1980

Plugging commenced 10-13-1980

Plugging completed 10-13-1980

Reason for abandonment of well or producing formation

No commercial quantity of oil or gas available


If a producing well is abandoned, date of last production 19

Was permission obtained from the Conservation Division or its agents before plugging was commenced? Yes

Name of Conservation Agent who supervised plugging of this well Gilbert Balthazar

Producing formation Depth to top Bottom Total Depth of Well 3880'

Show depth and thickness of all water, oil and gas formations.

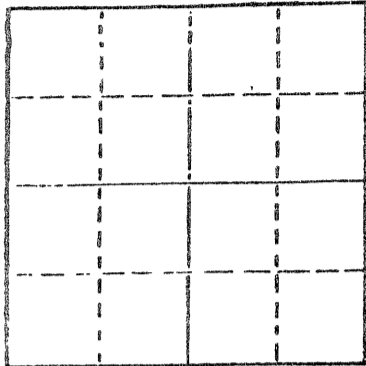

Locate well correctly on above Section Plat

OIL, GAS OR WATER RECORDS

CASING RECORD

FORMATION	CONTENT	FROM	TO	SIZE	PUT IN	PULLED OUT

Describe in detail the manner in which the well was plugged, indicating where the mud fluid was placed and the method or methods used in introducing it into the hold. If cement or other plugs were used, state the character of same and depth placed, from feet to feet for each plug set.

T.D. 3880'

Set 1st plug @ 850' with 70 sx.

2nd plug @ 360' with 20 sx.

3rd plug @ 40' solid bridge with 10 sx.

Rathole with 5 sx., 50/50 posmix, 6% gel

Plug was down @ 11:30 p.m. 10-13-80.

RECEIVED  
STATE CORPORATION COMMISSION

NOV 26 1980  
11-26-1980  
CONSERVATION DIVISION  
Wichita, Kansas

(If additional description is necessary, use BACK of this sheet)

Name of Plugging Contractor Abercrombie Drilling, Inc.

STATE OF Kansas COUNTY OF Sedgwick, ss.

Jack L. Partridge, Asst. Sec.-Treas. (employee of owner) or (owner or operator) of the above-described well, being first duly sworn on oath, says: That I have knowledge of the facts, statements, and matters herein contained and the log of the above-described well as filed and that the same are true and correct. So help me God.

(Signature)


*Jack L. Partridge*

801 Union Center, Wichita, Kansas  
(Address)

SUBSCRIBED AND SWORN TO before me this 24th day of November, 19 80

*Jeanette A. Metheny*  
Jeanette A. Metheny Notary Public.

My commission expires 08-18-84

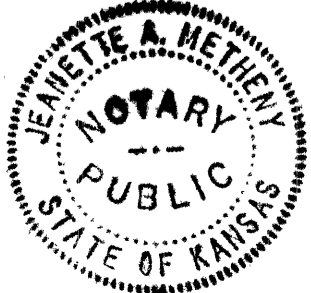

CORRECTED COPY  
CONTRACTOR'S WELL LOG

15-065-21317-00-00

OPERATOR:	K & E Drilling, Inc.
CONTRACTOR:	Abercrombie Drilling, Inc.
WELL NAME:	KORB #1
LOCATION:	NE SE NE, Section 32-8S-22W Graham County, Kansas
SPUD DATE:	10-08-80
COMPLETION DATE:	10-13-80

0	630	Shale
630	1817	Shale & Sand
1817	1850	Anhydrite
1850	2346	Shale
2346	3440	Shale & Lime
3440	3880	Lime
	3880	Rotary Total Depth

Spud hole @ 8:30 p.m. 10-08-80. Drilled 390' of a 12-1/4" hole. Ran 9 joints of 8-5/8" 24# used casing (tally 382.15'). Set @ 389'. Cemented with 250 sx. of Class A, 2% gel, 3% c.c. Plug was down @ 3:30 a.m. 10-09-80.

T.D. 3880'. Set 1st plug @ 850' with 70 sx., 2nd plug @ 360' with 20 sx., 3rd plug @ 40' solid bridge with 10 sx., rathole with 5 sx., 50/50 posmix, 6% gel. Plug was down @ 11:30 p.m. 10-13-80.

SAMPLE TOPS:

Anhydrite 1817'  
B/Anhydrite 1850'

RECEIVED  
STATE CORPORATION COMMISSION

NOV 26 1980

STATE OF KANSAS )  
                          ) SS  
COUNTY OF SEDGWICK )

CONSERVATION DIVISION  
Wichita, Kansas

Jack L. Partridge, Assistant Secretary-Treasurer of Abercrombie Drilling, Inc., does hereby state that the above and foregoing is a true and correct copy of the log of the KORB #1, NE SW NE, Section 32-8S-22W, Graham County, Kansas.

ABERCROMBIE DRILLING, INC.

BY: Jack L. Partridge  
Jack L. Partridge, Asst. Sec.-Treas

Subscribed and sworn to before me, a Notary Public, in and for the aforesaid county and state as of this 24th day of November, 1980.

Jeanette A. Metheny  
Jeanette A. Metheny, Notary Public

