

STATE OF KANSAS
STATE CORPORATION COMMISSION


15-065-20980-00-00

WELL PLUGGING RECORD

Give All Information Completely
Make Required Affidavit
Mail or Deliver Report to
Conservation Division
State Corporation Comm.
245 North Water
Wichita, KS 67202

Graham County, Sec. 33 Twp. 8 S Rge. 22E/W
Location as "NE/CNW $\frac{1}{4}$ SW $\frac{1}{4}$ " or footage from lines
NE NW NE

Lease Owner The National Oil Co.
Lease Name Elliott Well No. 1
Office Address 200 W. Douglas, Suite 550, Wichita, Ks. 67202
Character of Well (Completed as Oil, Gas or Dry Hole)
Dry Hole

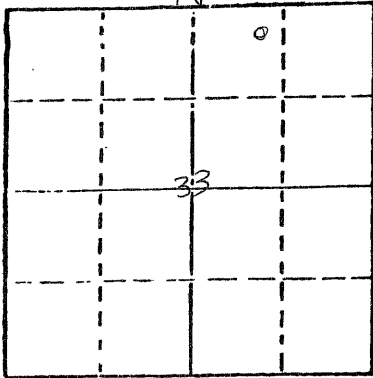

Locate well correctly on above
Section Plat

Date Well completed Jan. 12 1978
Application for plugging filed (verbally) Jan. 12 1978
Application for plugging approved (verbally) Jan. 12 1978
Plugging commenced Jan. 12 1978
Plugging completed Jan. 12 1978
Reason for abandonment of well or producing formation
No commercial quantity of oil or gas encountered
If a producing well is abandoned, date of last production
19

Was permission obtained from the Conservation Division or
its agents before plugging was commenced? Yes

Name of Conservation Agent who supervised plugging of this well Gilbert Balthazor
Producing formation _____ Depth to top _____ Bottom _____ Total Depth of Well 3882
Show depth and thickness of all water, oil and gas formations.

OIL, GAS OR WATER RECORDS

CASING RECORD

FORMATION	CONTENT	FROM	TO	SIZE	PUT IN	PULLED OUT

Describe in detail the manner in which the well was plugged, indicating where the mud fluid
was placed and the method or methods used in introducing it into the hold. If cement or other
plugs were used, state the character of same and depth placed, from _____ feet to
_____ feet for each plug set.

Set 1st plug at 850' with 70 sacks
2nd plug at 240' with 20 sacks
40' solid bridge with 10 sacks
Cemented with 50/50 posmix, 6% gel.
Job complete at 2:30 a.m., January 12, 1978

RECEIVED
STATE CORPORATION COMMISSION
JAN 18 1978
01-18-1978
CONSERVATION DIVISION
Wichita, Kansas

(If additional description is necessary, use BACK of this sheet)

Name of Plugging Contractor Abercrombie Drilling, Inc.

STATE OF Kansas COUNTY OF Sedgwick, ss.
Jack L. Partridge, Ass't. Secretary-Treasurer (employee of owner) or (owner or operator)
of the above-described well, being first duly sworn on oath, says: That I have knowledge of
the facts, statements, and matters herein contained and the log of the above-described well
as filed and that the same are true and correct. So help me God.

(Signature) Jack L. Partridge
801 Union Center, Wichita, Kansas 67202
(Address)

SUBSCRIBED AND SWORN TO before me this 17th day of January, 1978



Sandra Richman
Sandra Richman Notary Public.

My commission expires July 21, 1979

OPERATOR: The National Oil Co.
 CONTRACTOR: Abercrombie Drilling, Inc.
 WELL NAME: Elliott #1
 LOCATION: NE NW NE Section 33-8S-22W
 Graham County, Kansas
 SPUD DATE: January 4, 1978
 COMPLETION DATE: January 12, 1978

0	260	Surface soil, sand & shale
260	660	Shale
660	1735	Shale & sand
1735	1837	Shale & lime
1837	1873	Anhydrite
1873	2395	Shale
2395	2653	Shale & lime
2653	2786	Shale
2786	3124	Lime & shale
3124	3295	Shale
3295	3540	Lime & shale
3540	3587	Shale & lime
3587	3650	Lime
3650	3690	Lime & shale
3690	3882	Lime
	3882	Rotary Total Depth

RECEIVED
 STATE CORPORATION COMMISSION

SAMPLE TOPS:

Anhydrite 1848' (+414)
 B/Anhydrite 1875' (+387)

JAN 18 1978

CONSERVATION DIVISION
 Wichita, Kansas

Spud hole at 6:45 p.m., January 4, 1978. Drilled 260' of 12½" hole. Ran 6 joints of 8-5/8" - 23# casing. Set at 251.52'. Cemented with 190 sacks common cement, 2% gel, 3% CaCl. Cement did circulate. Plug was down at 12:45 a.m., January 5, 1978.


T.D. 3882'. Set 1st plug at 850' with 70 sacks, 2nd plug at 240' with 20 sacks, 3rd plug - 40' solid bridge with 10 sacks. Cemented with 50/50 posmix, 6% gel. Job complete at 2:30 a.m., January 12, 1978.

STATE OF KANSAS)
) ss
 COUNTY OF SEDGWICK)

Jack L. Partridge, Assistant Secretary-Treasurer of Abercrombie Drilling, Inc., does hereby state that the above and foregoing is a true and correct copy of the log of the Elliott #1, NE NW NE Section 33-8S-22W, Graham County, Kansas.

ABERCROMBIE DRILLING, INC.

BY Jack L. Partridge
 Jack L. Partridge,
 Assistant Secretary-Treasurer

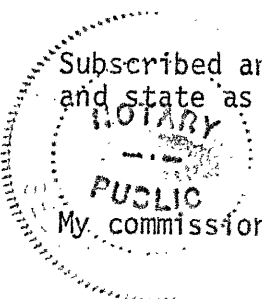

Subscribed and sworn to before me, a Notary Public, in and for the aforesaid county and state as of this 17th day of January, 1978.

Sandra Richman
 Sandra Richman, Notary Public

My commission expires July 21, 1979.