

15-065-01048-00-00

Give All Information Completely  
Make Required Affidavit  
Mail or Deliver Report to:  
Conservation Division  
State Corporation Commission  
211 No. Broadway  
Wichita, Kansas

WELL PLUGGING RECORD

Graham County, Sec. 9 Twp. 8S Rge. 23 (E) W (W)

Location as "NE/CNW&SW¼" or footage from lines NE/4 SW/4

Lease Owner Birmingham-Bartlett Drilling Co.

Lease Name KRAUS Well No. 1

Office Address 300 Kaufman Bldg., Wichita 2, Kansas

Character of Well (completed as Oil, Gas or Dry Hole) Dry Hole

Date well completed October 16, 19 62

Application for plugging filed (Verbal) October 16, 19 62

Application for plugging approved (Verbal) October 16, 19 62


Plugging commenced October 16, 19 62

Plugging completed October 16, 19 62

Reason for abandonment of well or producing formation Dry Hole

If a producing well is abandoned, date of last production 19

Was permission obtained from the Conservation Division or its agents before plugging was commenced? yes

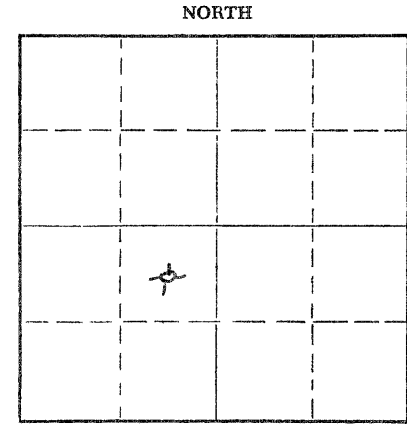

Locate well correctly on above Section Plat

Name of Conservation Agent who supervised plugging of this well Eldon Petty

Producing formation \_\_\_\_\_ Depth to top \_\_\_\_\_ Bottom \_\_\_\_\_ Total Depth of Well 3735 Feet

Show depth and thickness of all water, oil and gas formations.

OIL, GAS OR WATER RECORDS

CASING RECORD

FORMATION	CONTENT	FROM	TO	SIZE	PUT IN	PULLED OUT
		0	236'	8-5/8"	236'	none

Describe in detail the manner in which the well was plugged, indicating where the mud fluid was placed and the method or methods used in introducing it into the hole. If cement or other plugs were used, state the character of same and depth placed, from \_\_\_\_\_ feet to \_\_\_\_\_ feet for each plug set.

Set bottom plug at 540' with 20 sacks. cement.

Set middle plug at 180' with 20 sacks cement, mixed and

poured through pipe. Set top plug at 40' with 10 sacks cement.

RECEIVED  
STATE CORPORATION COMMISSION

OCT 19 1962

CONSERVATION DIVISION  
Wichita, Kansas

10-19-62

Name of Plugging Contractor Birmingham-Bartlett Drilling Co.  
Address 300 Kaufman Bldg., Wichita 2, Kansas

STATE OF KANSAS COUNTY OF SEDGWICK  
Richard Hindery, partner of Birmingham-Bartlett Drilling Co., owner, operator & contractor  
well, being first duly sworn on oath, says: That I have knowledge of the facts, statements, and matters herein contained and the log of the above-described well as filed and that the same are true and correct. So help me God. BIRMINGHAM-BARTLETT DRILLING CO.

(Signature) By Richard Hindery Partner  
300 Kaufman Bldg., Wichita 2, Kansas  
(Address)

SUBSCRIBED AND SWORN TO before me this 17th day of October, 19 62.

My commission expires October 2, 1966.

Beverly Larson  
Beverly Larson Notary Public.



INVOICED

DATE 10/19/62

INV. NO. 5890-W

15-065-01048-00-00

KRAUS NO. 1 WELL

LOCATION: NE/4 SW/4  
 Section 9-85-23W  
 Graham County, Kansas

SPUDDED: 10- 8-62  
 DRILLING  
 COMPLETED: 10-16-62

OWNER, OPERATOR  
 and CONTRACTOR: Birmingham-Bartlett Drilling Co.  
 300 Kaufman Bldg.  
 Wichita 2, Kansas

SURFACE CASING: 8-5/8" used casing cemented  
 at 236' with 165 sacks cement.

OIL STRING: None set. Dry hole.  
 Plugged on 10-16-62.

LOG

(Figures indicate bottom of formation)

0 -	235	Clay and shale
	1455	Shale and shells
	1655	Sand
	1893	Red bed
	1930	Anhydrite
	2310	Shale and shells
	3540	Shale and lime
	3590	Lime
	3615	Shale and lime
	3735	Lime
	3735	Rotary total depth

RECEIVED  
STATE CORPORATION COMMISSION

OCT 19 1962

CONSERVATION DIVISION  
Wichita, Kansas

10-19-62

The undersigned, Richard Hindery, one of the partners of Birmingham-Bartlett Drilling Co., hereby certifies that the above is a true and correct log of the KRAUS NO. 1 WELL as shown in the daily drilling reports.

BIRMINGHAM-BARTLETT DRILLING CO.

By Richard Hindery  
Richard Hindery, Partner

Subscribed and sworn to before me  
this 17th day of October, 1962.

Beverly Larson

Beverly Larson, Notary Public  
My commission expires October 2, 1966.