


Give All Information Completely
Make Required Affidavit
Mail or Deliver Report to:
Conservation Division
State Corporation Commission
800 Bitting Building
Wichita, Kansas

WELL PLUGGING RECORD

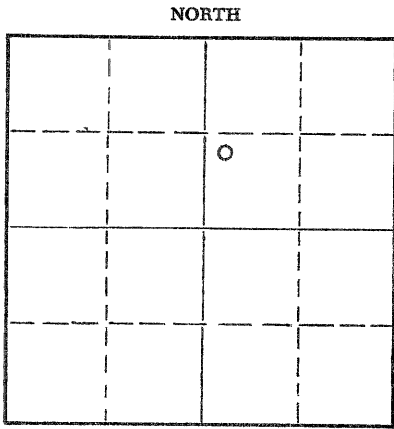

Locate well correctly on above Section Plat

Graham County. Sec. 15 Twp. 8 Rge. 23 (E) W (W)
Location as "NE/CNW/SW" or footage from lines NW SW NE
Lease Owner Nadel and Gussman
Lease Name Legere Well No. 1
Office Address 1714 First National Building
Character of Well (completed as Oil, Gas or Dry Hole) Dry
Date well completed 12-5-55
Application for plugging filed 12-5-55
Application for plugging approved 12-5-55
Plugging commenced 12-5-55
Plugging completed 12-5-55
Reason for abandonment of well or producing formation Dry

If a producing well is abandoned, date of last production _____ 19____
Was permission obtained from the Conservation Division or its agents before plugging was commenced? Yes

Name of Conservation Agent who supervised plugging of this well Eldon Petty
Producing formation _____ Depth to top _____ Bottom _____ Total Depth of Well 3877 Feet
Show depth and thickness of all water, oil and gas formations.

OIL, GAS OR WATER RECORDS

CASING RECORD

FORMATION	CONTENT	FROM	TO	SIZE	PUT IN	PULLED OUT
				8-5/8"	175'	0

Describe in detail the manner in which the well was plugged, indicating where the mud fluid was placed and the method or methods used in introducing it into the hole. If cement or other plugs were used, state the character of same and depth placed, from _____ feet to _____ feet for each plug set.

Filled hole with heavy mud from 3877 to 170' - set plug with 15 sacks cement - set second plug at 40' with 10 sacks cement.

(If additional description is necessary, use BACK of this sheet)

Name of Plugging Contractor Reserve Drilling Company, Inc.
Address 703 Union National Building, Wichita 2, Kansas

STATE OF KANSAS, COUNTY OF SEDGWICK, ss.

12-15-55

L. C. Hay (employee of owner) ~~or (owner or operator)~~ of the above-described well, being first duly sworn on oath, says: That I have knowledge of the facts, statements, and matters herein contained and the log of the above-described well as filed and that the same are true and correct. So help me God.

(Signature) R. C. Hay


Wichita, Kansas (Address)

SUBSCRIBED AND SWORN TO before me this 9th day of December, 19 55

My commission expires Nov. 3, 1956

Nola Babb

Notary Public.

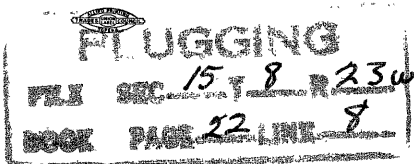

WELL LOG

Nadel and Gussman

Legere No. 1

NW SW NE 15-8-23W
Graham County, Kansas

Comm: 11-26-55
Comp: 12- 5-55

Casing: 175' 8-5/8" w/125 sex

Shale and sand	175
Shale and shells	1210
Sand	1235
Shale, red bed and sand	1410
Sand	1595
Red bed	1837
Anhydrite	1875
Shale and red bed	2200
Shale and shells	2500
Shale and lime	2860
Shale	2900
Shale and lime	3375
Lime	3660
Lime and shale	3850
Lime	3868
Arbuckle	3877

GEOLOGICAL TOPS

Topeka	3235
Heebner	3411
Toronto Lime	3438
Lansing-Kansas C.	3454
Base Kansas City	3671
Arbuckle	3847

STATE OF KANSAS)
) S SS:
 COUNTY OF SEDGWICK)

L. C. Hay, of lawful age, states that the above formations and depths are correct as shown by the daily drilling log of the Legere No. 1 Well in the NW SW NE 15-8-23W, Graham County, Kansas.

L. C. Hay

 L. C. Hay

Subscribed and sworn to before me this 9th day of December, 1955.

Nola Babb

 Nola Babb, Notary Public

My commission expires Nov. 3, 1956

PLUGGING
 FILE NO. 15-8-23W
 PAGE 22 LINE 8

12-15-55