


15-065-20412-00-00

Give All Information Completely  
Make Required Affidavit  
Mail or Deliver Report to:  
Conservation Division  
State Corporation Commission  
212 No. Market  
Wichita, Kansas

WELL PLUGGING RECORD

NORTH

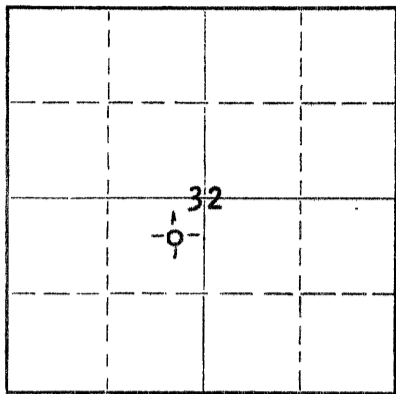

Locate well correctly on above Section Plat

GRAHAM County. Sec. 32 Twp. 8S Rge. 23W (E) (W)  
Location as "NE/CNW/SW" or footage from lines NE/4 NE/4 SW/4  
Lease Owner DANE G HANSEN TRUST  
Lease Name WILSON "K" Well No. 3  
Office Address LOGAN, KANSAS 67646  
Character of Well (completed as Oil, Gas or Dry Hole) DRY HOLE  
Date well completed FEBRUARY 5 1971  
Application for plugging filed FEBRUARY 5 1971  
Application for plugging approved FEBRUARY 5 1971  
Plugging commenced FEBRUARY 5 1971  
Plugging completed FEBRUARY 5 1971  
Reason for abandonment of well or producing formation TOO LOW STRUCTURALLY

If a producing well is abandoned, date of last production \_\_\_\_\_ 19\_\_\_\_  
Was permission obtained from the Conservation Division or its agents before plugging was commenced? YES

Name of Conservation Agent who supervised plugging of this well W L Nichols, Morland, Kansas  
Producing formation \_\_\_\_\_ Depth to top \_\_\_\_\_ Bottom \_\_\_\_\_ Total Depth of Well \_\_\_\_\_ Feet  
Show depth and thickness of all water, oil and gas formations.

OIL, GAS OR WATER RECORDS

CASING RECORD

FORMATION	CONTENT	FROM	TD	SIZE	PUT IN	PULLED OUT
				8-5/8"	207.90'	NONE

Describe in detail the manner in which the well was plugged, indicating where the mud fluid was placed and the method or methods used in introducing it into the hole. If cement or other plugs were used, state the character of same and depth placed, from \_\_\_\_\_ feet to \_\_\_\_\_ feet for each plug set.

FILLED WITH HEAVY MUD TO 1150'. SET PLUG. PUT IN 100 SACKS CEMENT. FILLED WITH HEAVY MUD TO 215'. SET PPLUG. PUT IN 20 SACKS CEMENT. FILLED WITH HEAVY MUD UP TO 40'. SET PLUG. FILLED TO TOP WITH 10 SACKS CEMENT.

RECEIVED  
STATE CORPORATION COMMISSION  
FEB 17 1971  
CONSERVATION DIVISION  
Wichita, Kansas

2/17/71

(If additional description is necessary, use BACK of this sheet)

Name of Plugging Contractor C-G DRILLING COMPANY  
Address 1107 UNION NATIONAL BUILDING, WICHITA, KANSAS 67202

STATE OF KANSAS, COUNTY OF SEDGWICK, ss. J. H. GALLOWAY


(employee of owner) or (owner or operator) of the above-described well, being first duly sworn on oath, says: That I have knowledge of the facts, statements, and matters herein contained and the log of the above-described well as filed and that the same are true and correct. So help me God.

(Signature) Jay H. Galloway 1107 UNION NATIONAL BLDG.  
(Address)

before me this 10TH day of FEBRUARY, 19 71

My commission expires December 7, 1971

Phyllis Buchanan  
Notary Public.

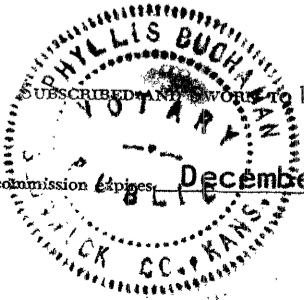

15-065-20412-00-00

WELL LOG

OPERATOR: DANE G. HANSEN TRUST

WELL NAME: WILSON K #3 LOCATION: NE NE SW SEC 32-8S-23W

COUNTY: GRAHAM STATE: KANSAS

WELL COMMENCED: JAN 29, 1971 WELL COMPLETED: FEB 5, 1971

ELEVATION: 2376 KB TOTAL DEPTH: 3940'

PRODUCTION: DRY & ABANDONED RIG NO: 1

CASING - 8-5/8": 11 JTS, 207.90' W/ 160 SX QUICKSET / 3 % CC

5-1/2":

ALL MEASUREMENTS TAKEN FROM THE TOP OF ROTARY BUSHING:

FROM	TO	FORMATION	DEVIATION FROM VERTICAL	REMARKS:
0	50	SAND		
50	695	SHALE		
695	1450	SAND AND SHALE	1° 1030'	
1450	1495	SHALE		
1495	1795	SAND		
1795	2040	SHALE	1° 1500'	
2040	2044	RED BED & SHALE	3° 2100'	
2044	2081	ANHYDRITE		
2081	2220	SHALE		
2220	2420	SHALE & SHELLS	3° 2248'	
2420	2585	SHALE & LIME	1 1/4° 2500'	
2585	3710	SHALE & LIME		
3775	3940	LIME		
3940		TOTAL DEPTH		

2/17/71

RECEIVED  
STATE CORPORATION COMMISSION  
FEB 17 1971  
CONSERVATION DIVISION  
Wichita, Kansas

STATE OF KANSAS )  
COUNTY OF SEDGWICK ) SS:

The undersigned hereby certifies that to the best of his knowledge and belief, the above facts are true and correct.

C-G DRILLING CO.

By Jay H. Galloway

SUBSCRIBED AND SWORN TO, BEFORE ME, This 10th day of February, 1971.

EXP. DEC. 7, 1971

Phyllis Buchanan  
PHYLLIS BUCHANAN - NOTARY PUBLIC

