


Give All Information Completely
Make Required Affidavit
Mail or Deliver Report to:
Conservation Division
State Corporation Commission
211 No. Broadway
Wichita, Kansas

WELL PLUGGING RECORD

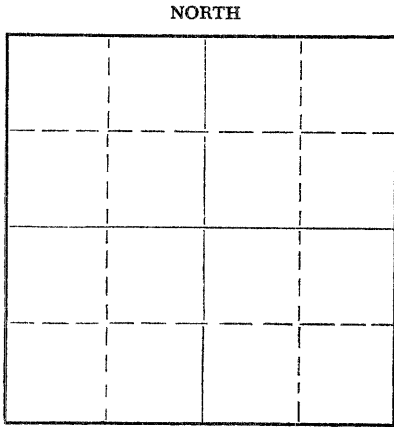

Locate well correctly on above
Section Plat

Graham

County. Sec. 33

Twp. 8

Rge. 23

(K) (W)

Location as "NE/CNW $\frac{1}{4}$ SW $\frac{1}{4}$ " or footage from lines NW NW SE

Lease Owner Herndon Drilling Company

Lease Name Quint Well No. 1

Office Address Drawer 489, Tulsa, Oklahoma

Character of Well (completed as Oil, Gas or Dry Hole) Dry Hole

Date well completed 8-13-57 19

Application for plugging filed 8-13-57 19

Application for plugging approved 8-13-57 19

Plugging commenced 8-13-57 19

Plugging completed 8-13-57 19

Reason for abandonment of well or producing formation _____

If a producing well is abandoned, date of last production _____ 19

Was permission obtained from the Conservation Division or its agents before plugging was commenced? Yes

Name of Conservation Agent who supervised plugging of this well Eldon Petty, Hays, Kansas

Producing formation _____ Depth to top _____ Bottom _____ Total Depth of Well 3950 Feet

Show depth and thickness of all water, oil and gas formations.

OIL, GAS OR WATER RECORDS

CASING RECORD

FORMATION	CONTENT	FROM	TO	SIZE	PUT IN	PULLED OUT

Describe in detail the manner in which the well was plugged, indicating where the mud fluid was placed and the method or methods used in introducing it into the hole. If cement or other plugs were used, state the character of same and depth placed, from 700 feet to 230 feet for each plug set. = 40 ft.

Hole filled to 700 feet with rotary mud = 20 Sx. cement was mixed and poured in pipe. Hole was filled to 230 feet and plug set and bridged. Mixed 20 Sx. cement and poured in pipe. Hole filled to 40 feet = mixed 10 Sx. cement and filled to bottom of cellar.

(If additional description is necessary, use BACK of this sheet)

Name of Plugging Contractor Herndon Drilling Company

Address Drawer 489, Tulsa, Oklahoma

STATE OF OKLAHOMA, COUNTY OF TULSA, ss. Tom Elliott

well, being first duly sworn on oath, says: That I have knowledge of the _____ (owner or operator) of the above-described above-described well as filed and that the same are true and correct. So help me God.

(Signature) Tom Elliott

Drawer 489, Tulsa, Oklahoma

(Address)

SUBSCRIBED AND SWORN to before me this 19th day of August, 1957

My commission expires January 27, 1960

Judy Kifer
Notary Public.

8/27/57

PLUGGING
FILE SEC. 33 T. 8 R. 23W
BOOK PAGE 39 LINE 4

17-065-00971-00-00

WELL LOG ON QUINT #1

Spudding date: 8/5/57
Date casing set: 8/5/57
Date rotary completed: 8/13/57
Date cable completed:

Location:

NW NW SE, Section 33-8S-23W, Graham County, Kansas

<u>FROM</u>	<u>TO</u>	<u>FORMATION</u>	<u>REMARKS</u>
0	140	Surface Hole	Ran 8 Jts, 8-5/8" 24# LS Casing, set at 235' and cemented w/200 Sx. Common Cement w/400# C.C.
140	600	Shale & Shells	
600	1249	Shale	
1249	1940	Shale & Shells	
1940	2030	Anhydrite	
2030	2305	Shale & Shells	
2305	2475	Shale & Lime	
2475	2955	Shale & Shells	
2955	2970	Shale	
2970	3255	Shale & Shells	
3255	3315	Shale	Plugged hole w/heavy mud to 700'. Mixed 20 Sx. Cement and poured through pipe. Filled hole to 230'. Mixed 20 Sx. Cement and poured through pipe. Filled hole to 40' and mixed 10 Sx. Cement and poured in hole.
3315	3646	Shale & Lime	
3646	3785	Lime	
3785	3950	Lime & Shale	
3950		Total Depth	

PLUGGING
 FILE: SEC 33 T 8 R 23W
 BOOK PAGE 39 LINE 4

Subscribed and sworn to before me this 19th day of August, 19 57

I certify the above and foregoing to be a true and exact copy of the original driller's log on the Quint #1.

HERNDON DRILLING COMPANY

[Signature]
Notary Public
My commission expires: 1-27-60

By: [Signature]
Title: Assistant Secretary

8/27/57