

15-065-20319-00-00


STATE OF KANSAS  
STATE CORPORATION COMMISSION

Form CP-4

Give All Information Completely  
Make Required Affidavit  
Mail or Deliver Report to:  
Conservation Division  
State Corporation Commission  
212 No. Market  
Wichita, Kansas

WELL PLUGGING RECORD

NORTH

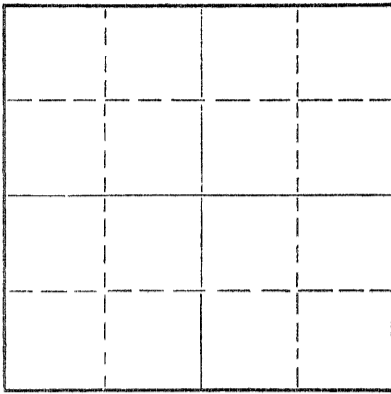

Locate well correctly on above  
Section Plat

County. Sec. 34 Twp. 8 Rge. 23 (E) W (W)  
Location as "NE/CNW/SW" or footage from lines. NE SW NW  
Lease Owner Leo J. Dreiling Oil Company  
Lease Name Dave Rush Well No. 2  
Office Address Route 2, Victoria, Kansas 67671  
Character of Well (completed as Oil, Gas or Dry Hole) Dry Hole  
Date well completed 4-15 19 70  
Application for plugging filed 4-15 19 70  
Application for plugging approved 4-15 19 70  
Plugging commenced 4-15 19 70  
Plugging completed 4-15 19 70  
Reason for abandonment of well or producing formation Dry Hole

If a producing well is abandoned, date of last production \_\_\_\_\_ 19\_\_\_\_  
Was permission obtained from the Conservation Division or its agents before plugging was commenced? Yes

Name of Conservation Agent who supervised plugging of this well W. L. Nichols  
Producing formation \_\_\_\_\_ Depth to top \_\_\_\_\_ Bottom \_\_\_\_\_ Total Depth of Well \_\_\_\_\_ Feet  
Show depth and thickness of all water, oil and gas formations.


OIL, GAS OR WATER RECORDS

CASING RECORD

FORMATION	CONTENT	FROM	TO	SIZE	PUT IN	PULLED OUT
Surface Pipe				8 5/8"	188'	

Describe in detail the manner in which the well was plugged, indicating where the mud fluid was placed and the method or methods used in introducing it into the hole. If cement or other plugs were used, state the character of same and depth placed, from \_\_\_\_\_ feet to \_\_\_\_\_ feet for each plug set.

1st. plug was set at 1025' with 70 cubic feet  
2nd. plug was set at 215' with 20 cubic feet  
3rd. plug was set at 40' with 10 cubic feet  
Cementing to bottom of cellar

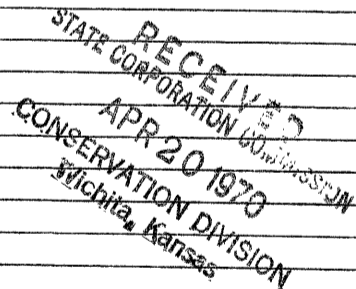

(If additional description is necessary, use BACK of this sheet)

Name of Plugging Contractor L. J. Dreiling & Sons, Inc.  
Address Route 2, Victoria, Kansas 67671

H-20-70

STATE OF KANSAS, COUNTY OF ELLIS, ss.

I, Leo F. Dreiling

(employee of owner) or (owner or operator) of the above-described

well, being first duly sworn on oath, says: That I have knowledge of the facts, statements, and matters herein contained and the log of the above-described well as filed and that the same are true and correct. So help me God.

(Signature)

Leo F. Dreiling, Route 2, Victoria, Kansas 67671  
(Address)

SUBSCRIBED AND SWORN TO before me this 17th day of April, 19 70

My commission expires September 19, 1970

Joseph A. Hess  
JOSEPH A. HESS

Notary Public.

