

15-065-21187-0000


STATE OF KANSAS  
STATE CORPORATION COMMISSION

WELL PLUGGING RECORD

Give All Information Completely  
Make Required Affidavit  
Mail or Deliver Report to  
Conservation Division  
State Corporation Comm.  
245 North Water  
Wichita, KS 67202

Graham County, Sec. 35 Twp. 8S Rge. 23W E/W  
Location as "NE/CNW/SW" or footage from lines  
100' N of NW SE SE

Lease Owner Suburban Propane Gas Corporation  
Lease Name MOORE Well No. 1  
Office Address P. O. Box 17689, San Antonio, Texas  
Character of Well (Completed as Oil, Gas or Dry Hole)  
Dry Hole

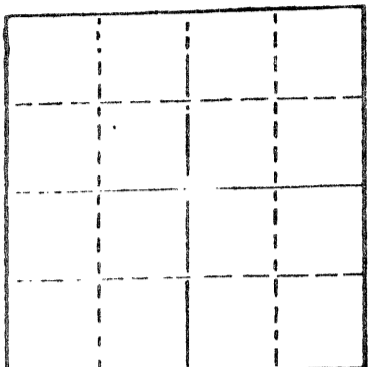

Locate well correctly on above  
Section Plat

Date Well completed Jan. 27 19 80  
Application for plugging filed (verbally) Jan. 27 19 80  
Application for plugging approved (verbally) Jan. 27 19 80  
Plugging commenced Jan. 27 19 80  
Plugging completed Jan. 27 19 80  
Reason for abandonment of well or producing formation  
No commercial quantity of oil or gas encountered  
If a producing well is abandoned, date of last production  
19

Was permission obtained from the Conservation Division or  
its agents before plugging was commenced? Yes

Name of Conservation Agent who supervised plugging of this well Gilbert Balthazor  
Producing formation Depth to top Bottom Total Depth of Well 4115'  
Show depth and thickness of all water, oil and gas formations.

OIL, GAS OR WATER RECORDS

CASING RECORD

FORMATION	CONTENT	FROM	TO	SIZE	PUT IN	PULLED OUT

Describe in detail the manner in which the well was plugged, indicating where the mud fluid  
was placed and the method or methods used in introducing it into the hold. If cement or other  
plugs were used, state the character of same and depth placed, from \_\_\_\_\_ feet to  
\_\_\_\_\_ feet for each plug set.

T.D. 4115'  
Set 1st plug at 850' with 70 sacks  
2nd plug at 240' with 20 sacks  
3rd plug at 40' solid bridge with 10 sacks  
rathole with 5 sacks.  
Cemented with 50/50 posmix, 6% gel.  
Plug was down at 2:30 p.m., 01-27-80.

RECEIVED  
STATE CORPORATION COMMISSION  
JAN 31 1980

(If additional description is necessary, use BACK of this sheet)

Name of Plugging Contractor Abercrombie Drilling, Inc. 1-31-80

STATE OF Kansas COUNTY OF Sedgwick, ss.  
Jack L. Partridge, Asst. Sec.-Treas. (employee of owner) or (owner or operator)  
of the above-described well, being first duly sworn on oath, says: That I have knowledge of  
the facts, statements, and matters herein contained and the log of the above-described well  
as filed and that the same are true and correct. So help me God.

(Signature) Jack L. Partridge  
801 Union Center, Wichita, Kansas 67202  
(Address)

SUBSCRIBED AND SWORN TO before me this 29th day of January, 19 80



Sherrie L. Brooks  
Notary Public.

My commission expires 08-21-82

15-065-21187-0000

CONTRACTOR'S WELL LOG

OPERATOR:	Suburban Propane Gas Corporation
CONTRACTOR:	Abercrombie Drilling, Inc.
WELL NAME:	Moore #1
LOCATION:	100' N of NW SE SE, Section 35-8S-23W, Graham County, Kansas
SPUD DATE:	January 21, 1980
COMPLETION DATE:	January 27, 1980

0	40	Clay, sand and shale
40	260	Sand and shale
260	1090	Shale
1090	1825	Shale and sand
1825	1869	Shale
1869	1905	Anhydrite
1905	3545	Shale
3545	3767	Lime and shale
3767	3875	Lime
3875	4020	Lime and Conglomerate
4020	4115	Lime
	4115	Rotary Total Depth

RECEIVED  
 JAN 31 1980  
 1-31-80

Spud hole at 4:45 p.m., January 21, 1980. Drilled 260' of 12 1/4" hole. Ran 6 joints of 8-5/8" new 23# casing. (Talley 250'). Set at 257' RTD with 200 sacks of common cement, 3% Ca.Cl., 2% gel. Cement did circulate. Pumped plug to 243'. Plug was down at 3:50 p.m., January 21, 1980.

T.D. 4115'. Set 1st plug at 850' with 70 sacks, 2nd plug at 240' with 20 sacks, 3rd plug at 40' solid bridge with 10 sacks and rathole with 5 sacks. Cemented with 50/50 posmix, 6% gel. Plug was down at 2:30 p.m., January 27, 1980.

SAMPLE TOPS:

Anhydrite	1869'
B/Anhydrite	1905'

STATE OF KANSAS        )  
                                   ) ss  
 COUNTY OF SEDGWICK )

Jack L. Partridge, Assistant Secretary-Treasurer of Abercrombie Drilling, Inc., does hereby state that the above and foregoing is a true and correct copy of the log of the Moore #1, 100' N of NW SE SE, Section 35-8S-23W, Graham County, Kansas.

ABERCROMBIE DRILLING, INC.

BY Jack L. Partridge  
 Jack L. Partridge  
 Assistant Secretary-Treasurer

Subscribed and sworn to before me, a Notary Public, in and for the county and state aforesaid, as of this 29th day of January, 1980.



Sherrie L. Brooks  
 Sherrie Brooks, Notary Public

My commission expires 08-21-82.