


15-065-03370-00-00

STATE OF KANSAS
STATE CORPORATION COMMISSION

WELL PLUGGING RECORD

Give All Information Completely
Make Required Affidavit
Mail or Deliver Report to:
Conservation Division
State Corporation Commission
211 No. Broadway
Wichita, Kansas

NORTH

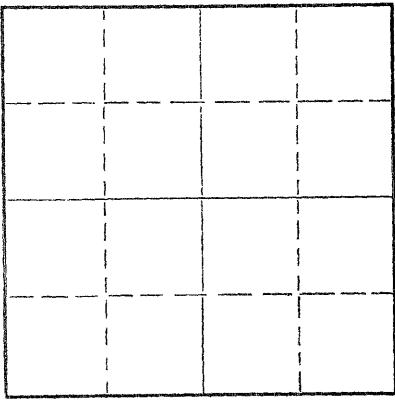

Locate well correctly on above
Section Plat

Graham County. Sec. 11 Twp. 8S Rge. 24 ~~xxx~~ (W)
Location as "NE/CNW/SW" or footage from lines A/C S/2 NE/4 NE/4
Lease Owner Barnett Oil Company, Et Al
Lease Name Paxson "A" Well No. 1
Office Address 411 First Nat'l Bank Bldg., Wichita, Kansas
Character of Well (completed as Oil, Gas or Dry Hole) Oil
Date well completed January 28, 19 50
Application for plugging filed June 11, 19 58
Application for plugging approved June 5, 19 58
Plugging commenced May 22, 19 58
Plugging completed May 25, 19 58
Reason for abandonment of well or producing formation Oil Depleted -
Well has been abandoned since March, 1953
If a producing well is abandoned, date of last production March, 19 53
Was permission obtained from the Conservation Division or its agents before plugging was commenced? Yes

Name of Conservation Agent who supervised plugging of this well Mr. Fabricius
Producing formation Kansas City Depth to top 3588' Bottom 3782' Total Depth of Well 3782' Feet
Show depth and thickness of all water, oil and gas formations.

OIL, GAS OR WATER RECORDS

CASING RECORD

FORMATION	CONTENT	FROM	TO	SIZE	PUT IN	PULLED OUT
				8 5/8"	130'	None
				5 1/2"	3,782'	687'

Describe in detail the manner in which the well was plugged, indicating where the mud fluid was placed and the method or methods used in introducing it into the hole. If cement or other plugs were used, state the character of same and depth placed, from _____ feet to _____ feet for each plug set.

Measured into T.D. 3782'.
Plugging started 5-22-58. Finished 5-25-58.
Plugged off bottom with sand to 3745' and dumped 4 sacks cement.
Shot 5 1/2" casing at 687'. Pulled pipe out of hole and mudded to 125'.
Set rock bridge and dumped 25 sacks cement. Filled hole with mud to 40'. Set rock bridge and mixed 10 sacks cement for cap on well.
Well completed.

(Well Log attached)

6-12-58

(If additional description is necessary, use BACK of this sheet)
Name of Plugging Contractor J. O. Forbes d/b/a Forbes Casing Pulling Co.
Address Box 221, Great Bend, Kansas


STATE OF Kansas, COUNTY OF Sedgwick, ss.
F. H. Rousey, (employee of ~~owner~~ operator) of the above-described well, being first duly sworn on oath, says: That I have knowledge of the facts, statements, and matters herein contained and the log of the above-described well as filed and that the same are true and correct. So help me God.

(Signature) F. H. Rousey
411 First Nat'l Bank Bldg., Wichita, Kansas
(Address)

SUBSCRIBED AND SWORN TO before me this 11th day of June, 1958

My commission expires February 27, 1960.

Mildred F. Willis
Notary Public.

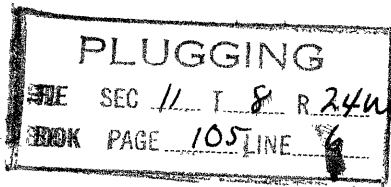

15 065-03370-00-00

BARNETT OIL COMPANY
WELL LOG - PAXSON "A" NO. 1
A/C S/2 NE/4 NE/4 SECTION 11-8S-24W
GRAHAM COUNTY, KANSAS

<u>From</u>	<u>To</u>	<u>Formation</u>
0	130	Surface and clay
130	880	Shale
880	1480	Shale and shells
1480	1500	Shale
1500	1700	Sand and shale
1700	1980	Shale and shells
1980	2015	Anhydrite
2015	2405	Shale and shells
2405	2920	Lime and shale
2920	3020	Shale and lime
3020	3380	Lime
3380	3560	Lime and shale
3560	3782	Lime (T.D.)

Set 130' of 8 5/8" w/100 sacks
of cement.

Set 3782' of 5 1/2", 11# s.s. casing
w/ 75 sacks of cement.

672-58

