

15-173-03824-00-01

STATE OF KANSAS
STATE CORPORATION COMMISSION


WELL PLUGGING RECORD

Give All Information Completely
Make Required Affidavit
Mail or Deliver Report to:
Conservation Division
State Corporation Commission
800 Bittling Building
Wichita, Kansas

OR

FORMATION PLUGGING RECORD

Strike out upper line
when reporting plug-
ging off formations.

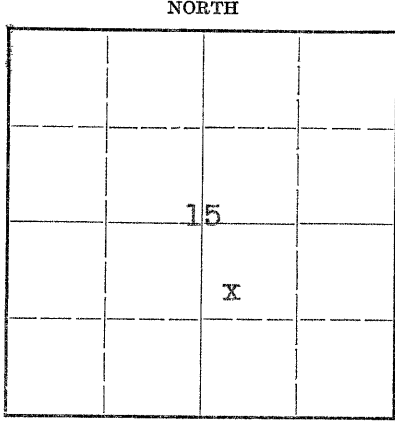

Locate well correctly on above
Section Plat

Sedgwick County. Sec. 15 Twp. 26S Rge. 2 (E) (W)
Location as "NE1/4NW1/4SW1/4" or footage from lines SW NW SE
Lease Owner SHELL OIL COMPANY INC.
Lease Name K. F. Fischer Well No. 4
Office Address Box 650, McPherson, Kansas
Character of Well (completed as Oil, Gas or Dry Hole) Oil
Date well completed 11 19 29
Application for plugging filed 5-1 19 47
Application for plugging approved 5-6 19 47
Plugging commenced 5-14 19 47
Plugging completed 5-21 19 47
Reason for abandonment of well or producing formation well depleted

If a producing well is abandoned, date of last production 10 19 44
Was permission obtained from the Conservation Division or its agents before plugging was com-
menced? Yes

Name of Conservation Agent who supervised plugging of this well S. S. Greider
Producing formation Viola Depth to top 3202 1/2 Bottom 3208 1/2 Total Depth of Well 3208 1/2 Feet

Show depth and thickness of all water, oil and gas formations.

OIL, GAS OR WATER RECORDS

CASING RECORD

Formation	Content	From	To	Size	Put In	Pulled Out
Viola	oil-water	3202 1/2	3208 1/2	15 1/2"	80'	Left in hole
				8-5/8"	2855'	2155'
				7"	3198	2888'

Describe in detail the manner in which the well was plugged, indicating where the mud fluid was placed and the method or methods used in introducing it into the hold. If cement or other plugs were used, state the character of same and depth placed, from.....feet to
.....feet for each plug set.

3208 1/2' To 3178' PB W/Cement
3178' 115' PB W/Mud
115' 103' PB W/Cement
103' 10' PB W/Mud
10' 0' Capped W/9 Sacks Cement

RECEIVED
5/29/47
MAY 29 1947

(If additional description is necessary, use BACK of this sheet)

Correspondence regarding this well should be addressed to R. T. McNally, Sup't.
Address Box 650, McPherson, Kansas

STATE OF Kansas, COUNTY OF McPherson, ss.
R. T. McNally (employee of owner) or (owner or operator) of the above-described well,

being first duly sworn on oath, says: That I have knowledge of the facts, statements, and matters herein contained and the log of the above-described well as filed and that the same are true and correct. So help me God.

(Signature)

R. T. McNally

Box 650, McPherson, Kansas
(Address)

SUBSCRIBED AND SWORN to before me this 27th day of May, 19 47

Notary Public

My commission expires 9-14-1950

PLUGGING
FIL 15 26 R 2F
108 38

15-173-03824-00-01

WELL LOG

WELL: K. F. Fischer No. 4

CASING RECORD

LOC.: SW NW SE, Section 15-26S-2E

15 1/8" Cem. at 80'; 8-5/8" Cem. at 2855';
7" Cem. at 3198' with 75 Sacks L. S.

0 80 Clay-sand
 160 Sand
 250 Broken lime
 280 Shale
 310 Broken lime
 450 Shale
 465 Broken lime
 670 Shale
 700 Broken lime
 875 Shale
 900 Shale-shells
 1000 Shale
 1200 Sandy shale
 1445 Shale
 1500 Broken lime
 1620 Shale
 1670 Broken lime
 1700 Shale
 1790 Broken lime
 1825 Shale
 1885 Shale-shells
 1925 Shale
 1950 Lime
 2050 Shale
 2095 Lime
 2115 Shale
 2140 Lime
 2215 Shale
 2265 Lime
 2290 Shale
 2315 Lime
 2350 Shale
 2400 Broken lime
 2500 Shale
 2525 Broken lime
 2550 Shale
 2560 Broken lime
 2630 Shale
 2640 Lime
 2670 Shale
 2858 Lime
 2871 Green shale
 2881 Red-green shale
 2883 Lime
 2884 Variegated shale
 2892 1/8 " " lime
 2895 " " "
 2921 Green shale-lime
 2926 Chat TD

DEEPENED: IV-32.

2926 OTD Chat
 3036 Chat
 3147 Lime
 3194 Shale
 3201 SLC
 3202 1/8 Shale
 3208 1/8 Lime
 3208 1/8 TD

COMPLETE: VI-32.

COMPLETE: XI-29.

PLUGGING
 FILE SEC 15 T 26 R 2E
 BOOK PAGE 108 LINE 38

MAY 6 - 1947