

Give All Information Completely  
Make Required Affidavit  
Mail or Deliver Report to:  
Conservation Division  
State Corporation Commission  
800 Biting Building  
Wichita, Kansas

OR

FORMATION PLUGGING RECORD

Strike out upper line when reporting plugging of formations.

Sedgwick County. Sec. 15 Twp. 26S Rge. 2 (E) (W)  
Location as "NE¼NW¼SW¼" or footage from lines. NE NE SW  
Lease Owner. SHELL OIL COMPANY, INC.  
Lease Name. P.F. Lygrisse "B" Well No. 1  
Office Address. Box 650 McPherson, Kansas.  
Character of Well (completed as Oil, Gas or Dry Hole). Oil Well  
Date well completed. April 1931  
Application for plugging filed. 6-12-1946  
Application for plugging approved. 6-14-1946  
Plugging commenced. 6-29-1946  
Plugging completed. 7-22-1946  
Reason for abandonment of well or producing formation. Well Depleted

NORTH

	X		

Locate well correctly on above Section Plat

If a producing well is abandoned, date of last production. April 1945  
Was permission obtained from the Conservation Division or its agents before plugging was commenced? Yes

Name of Conservation Agent who supervised plugging of this well. Ruel Durkee  
Producing formation. Viola Depth to top. 3200 Bottom. 3204 Total Depth of Well. 3204 Feet  
Show depth and thickness of all water, oil and gas formations.

OIL, GAS OR WATER RECORDS


CASING RECORD

Formation	Content	From	To	Size	Put In	Pulled Out
Viola	Oil & Water	3200	3204	15-1/2"	110'	Left in Hole
				8-5/8"	2550'	Rec. 1938
				7"	2900'	Rec. 2900
				5-1/2"	3170'	Rec. 1963

Describe in detail the manner in which the well was plugged, indicating where the mud fluid was placed and the method or methods used in introducing it into the hole. If cement or other plugs were used, state the character of same and depth placed, from \_\_\_\_\_ feet to \_\_\_\_\_ feet for each plug set.

3204 to 3180 PB w/cement  
3180 to 150 PB w/mud  
150 to 130 PB w/rock  
130 to 118 PB w/cement  
118 to base of cellar PB w/mud  
Capped into cellar with 10 sacks of cement.

15 26 2E  
58 43

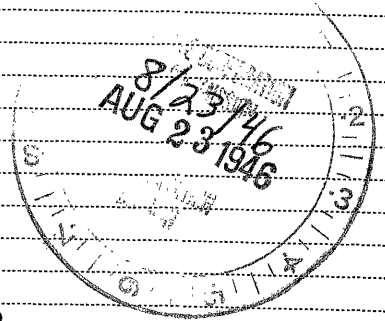

(If additional description is necessary, use BACK of this sheet)

Correspondence regarding this well should be addressed to R. T. McNally, Sup't. SHELL OIL CO. INC.  
Address. Box 650 McPherson, Kansas.

STATE OF Kansas, COUNTY OF McPherson, ss.  
R. T. McNally, Sup't. (employee of owner) or (owner or operator) of the above-described well,  
being first duly sworn on oath, says: That I have knowledge of the facts, statements, and matters herein contained and the log of the above-described well as filed and that the same are true and correct. So help me God.

(Signature)

R. T. McNally

Box 650 McPherson, Kansas.  
(Address)

SUBSCRIBED AND SWORN to before me this 21 day of August 1946

My commission expires Dec. 20th. 1946

J. S. White  
Notary Public.

WELL LOG

15-173-00814-00-00

WELL: P. F. Lygrisse "B" No. 1  
 LOCATION: NE NE SW, SEC. 15-26S-2E

15 1/8" Set @ 110'  
 13-3/8 Set @ 1090' 6-5/8" U.R. @ 2900'  
 10" Set @ 1415' 5-3/16 Set @ 3170'  
 8 1/4" Set @ 2550'

0	80	Shale	1230	Shale
	100	Lime	1245	Lime
	110	Shale	1255	Shale
	125	Lime	1265	Lime
	135	Shale	1280	Shale
	160	Lime	1285	Lime
	170	Shale	1390	Shale
	180	Lime	1400	Sand
	200	Shale	1430	Lime
	210	Lime	1445	Shale
	245	Shale	1455	Lime
	280	Lime	1470	Shale
	290	Shale	1495	Lime
	300	Lime	1515	Shale
	315	Shale	1580	Lime
	345	Lime	1600	Shale
	350	Shale	1630	Lime
	360	Lime	1645	Shale
	370	Shale	1665	Lime
	455	Lime	1690	Shale
	475	Shale	1735	Shale & shells
	485	Lime	1765	Lime
	495	Shale	1815	Shale
	550	Lime	1885	Lime
	560	Shale	1905	Shale
	565	Red rock	1925	Lime
	575	Lime	2005	Shale
	600	Shale	2085	Sandy shale
	605	Lime	2090	Shale
	630	Shale	2105	Lime
	655	Lime	2115	Shale
	690	Shells	2155	Lime
	700	Lime	2235	Shale
	725	Shale	2280	Lime
	745	Lime	2320	Slate
	780	Shale	2325	Lime
	790	Lime	2335	Shale
	800	Shale	2365	Lime
	865	Lime	2425	Shale
	870	Shale	2505	Lime
	875	Lime	2530	Sand
	900	Shale	2615	Lime
	945	Shale & shells	2710	Shale
	955	Slate	2720	Lime & shale
	965	Red rock	2745	Shale
	980	Shale	2840	Lime & shale
	985	Red rock	2880	Shale
1000	Shale & shells	2882	Lime	
1020	Shale	2900	Shale	
1065	Lime	2910	Chert	
1140	Shale	2925	Lime	
1150	Lime	2930	Slate & lime	
1185	Shale			
1200	Lime			

2955 Lime  
 3145 Lime  
 3200 Shale  
 3204 Lime TD

COMPLETE: 4-1931.

ELEVATION: 1400'  
 DISTRICT: Greenwich  
 COUNTY: Sedgwick  
 STATE: Kansas

PLUGGING  
 FILE SEC-15-26-2E  
 BOOK PAGE 58 LINE 43

