

15-173-03472-00-00

STATE OF KANSAS
STATE CORPORATION COMMISSION

WELL PLUGGING RECORD

OR

FORMATION PLUGGING RECORD


Strike out upper line when reporting plugging off formations.

Give All Information Completely
Make Required Affidavit
Mail or Deliver Report to:
Conservation Division
State Corporation Commission,
800 Biting Building,
Wichita, Kansas

8/14/36

AA

NORTH

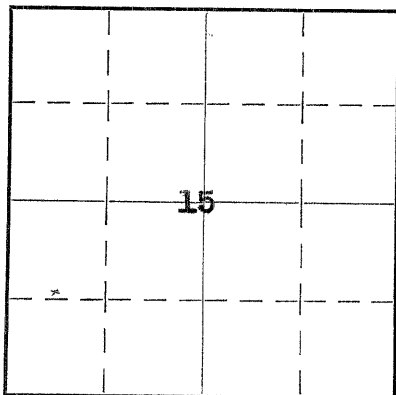

Locate well correctly on above Section Plat

Sedgwick County. Sec. 15 Twp 26S. Rge 2 (E) (W)

Location as "NE 1/4 NW 1/4 SW 1/4" or footage from lines C SL NW SW/4

Lease Owner Shell Petroleum Corporation

Lease Name P. F. Lygrisse "B" Well No. 4

Office Address Greenwich, Kansas

Character of Well (Completed as Oil, Gas or Dry Hole) Salt water disposal well.

Date, well completed November 4, 1929

Application for plugging filed July 28, 1936

Application for plugging approved July 29, 1936

Plugging Commenced July 29, 1936

Plugging Completed August 8, 1936

Reason for abandonment of well or producing formation Abandoned as a salt water disposal well.

If a producing well is abandoned, date of last production 1936

Was permission obtained from the Conservation Division or its agents before plugging was commenced? Yes

Name of Conservation Agent who supervised plugging of this well Hal C. Smith

Producing formation Depth to top Bottom Total Depth of Well 2020 Feet

Show depth and thickness of all water, oil and gas formations.

OIL, GAS OR WATER RECORDS

CASING RECORD

Formation	Content	From	To	Size	Put In	Pulled Out
				16 "	87	None
				8-5/8	1896	None
16" O.D. casing was cemented with 200 sacks of cement. 8-5/8" O. D. casing was cemented with 50 sacks of cement. In addition, 450 sacks of cement were pumped in between the 8-5/8" and 16" O.D. casing and the cellar was cemented with 50 sacks. This cementing was done at time of original completion.						


Describe in detail the manner in which the well was plugged, indicating where the mud fluid was placed and the method or methods used in introducing it into the hole. If cement or other plugs were used, state the character of same and depth placed, from feet to feet for each plug set.

2020 - 1700 (Approximately) Plugged back with 100 sacks of cement.

1700 - 20 Filled with heavy mud. Set wooden plug at 20 feet.

20 - 0 Plugged back with 6 sacks of cement.

This well was originally drilled to a total depth of 2923 feet, a penetration of 26 feet in the Mississippi chat. However, as the hole was dry, it was immediately plugged back to 2020 feet under the supervision of the State plugging agent and reconditioned as a salt water disposal well. No salt water has been injected into this well since December, 1931.

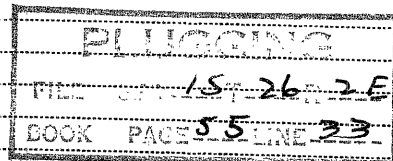

(If additional description is necessary use BACK of this sheet)

Correspondence regarding this well should be addressed to Shell Petroleum Corporation
Address Greenwich, Kansas

STATE OF Kansas, COUNTY OF Sedgwick, ss. W. M. Gholson

(employee of owner) or (owner or operator) of the above-described well, being first duly sworn on oath, says: That I have knowledge of the facts, statements, and matters herein contained and the log of the above-described well as filed and that the same are true and correct. So help me God.

(Signature) W. M. Gholson

SHELL PETROLEUM CORP., GREENWICH, KANSAS (Address)

SUBSCRIBED AND SWORN to before me this 13th day of August 1936

My commission expires Sept 12 - 1939