




STATE OF KANSAS  
STATE CORPORATION COMMISSION

Give All Information Completely  
Make Required Affidavit  
Mail or Deliver Report to:  
Conservation Division  
State Corporation Commission  
211 No. Broadway  
Wichita, Kansas

WELL PLUGGING RECORD

Sedwick County, Sec. 15 Twp. 25 Rge. 1 (E) (W)

Location as "NE/CNW/SW" or footage from lines SE SE E  
Lease Owner Reading & Bates Offshore Drilling Co.  
Lease Name Lygrisse Well No. 1  
Office Address 11th Floor, Biltmore Bldg., Tulsa, Oklahoma  
Character of Well (completed as Oil, Gas or Dry Hole) ~~S~~ EOR KCC ZAY  
Date well completed 19  
Application for plugging filed 19  
Application for plugging approved 19  
Plugging commenced 7-20-65 19  
Plugging completed 8-11-65 19  
Reason for abandonment of well or producing formation completed

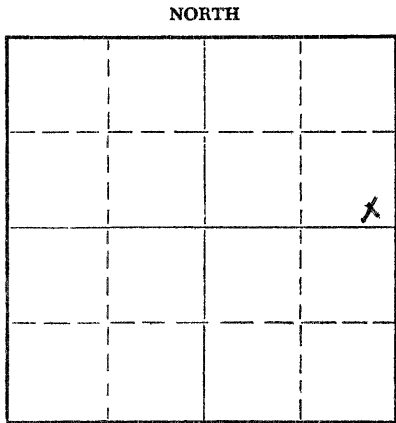

Locate well correctly on above Section Plat

If a producing well is abandoned, date of last production 19  
Was permission obtained from the Conservation Division or its agents before plugging was commenced? yes

Name of Conservation Agent who supervised plugging of this well Paul Turpin  
Producing formation \_\_\_\_\_ Depth to top \_\_\_\_\_ Bottom \_\_\_\_\_ Total Depth of Well 3315 Feet  
Show depth and thickness of all water, oil and gas formations.

OIL, GAS OR WATER RECORDS

CASING RECORD

FORMATION	CONTENT	FROM	TO	SIZE	PUT IN	PULLED OUT
				24	20	none
				20	78	none
				1 1/2	780	none
				1 1/2	1320	897.00
				1 3/4	1750	1754.00
				8 5/8	2770	2741.00
				7	3380	595.00

Describe in detail the manner in which the well was plugged, indicating where the mud fluid was placed and the method or methods used in introducing it into the hole. If cement or other plugs were used, state the character of same and depth placed, from \_\_\_\_\_ feet to \_\_\_\_\_ feet for each plug set.

Fill below with sand to 3075' and dump 5 sacks cement.  
Set 13' rock bridge from 200' to 185' and dump 4 yards  
risky mix concrete. Mud hole to 25', set 5' rock bridge  
and dump 2 yards risky mix concrete

RECEIVED  
STATE CORPORATION COMMISSION

8/20/65  
AUG 20 1965

CONSERVATION DIVISION  
Wichita, Kansas

(If additional description is necessary, use BACK of this sheet)  
Name of Plugging Contractor Flint Engineering & Construction Company  
Address Box 950, El Dorado, Kansas

STATE OF \_\_\_\_\_, COUNTY OF \_\_\_\_\_, ss.

\_\_\_\_\_, (employee of owner) or (owner or operator) of the above-described well, being first duly sworn on oath, says: That I have knowledge of the facts, statements, and matters herein contained and the log of the above-described well as filed and that the same are true and correct. So help me God.

(Signature) Janice Bawdle

\_\_\_\_\_, (Address) \_\_\_\_\_

SUBSCRIBED AND SWORN to before me this 18th day of August, 1965

My commission expires \_\_\_\_\_

5-27-67

Ronald R. Hanson  
Notary Public.