

WELL PLUGGING RECORD

STATE OF KANSAS STATE CORPORATION COMMISSION Give All Information Completely Make Required Affidavit Mail or Deliver Report to: Conservation Division State Corporation Commission 800 Bittling Building Wichita, Kansas

OR FORMATION PLUGGING RECORD

Strike out upper line when reporting plugging off formations.

Sedgwick County. Sec. 15 Twp. 26S Rge. 2 (E) (W)

Location as "NE 1/4 NW 1/4 SW 1/4" or footage from lines. SHELL OIL COMPANY, INC.

Lease Owner. P. F. Lygrisse "A" Well No. 10

Office Address. Box 650, McPherson, Kansas

Character of Well (completed as Oil, Gas or Dry Hole) Oil

Date well completed. 3-28-1947

Application for plugging filed. 4-3-1947

Application for plugging approved. 5-8-1947

Plugging commenced. 5-14-1947

Plugging completed.

Reason for abandonment of well or producing formation well depleted


If a producing well is abandoned, date of last production. 10-5-1946

Was permission obtained from the Conservation Division or its agents before plugging was commenced? Yes

Name of Conservation Agent who supervised plugging of this well. S. S. Grieder, Wichita, Kansas

Producing formation. Viola Depth to top. 3180' Bottom. 3183' Total Depth of Well. 3183 Feet

Show depth and thickness of all water, oil and gas formations.

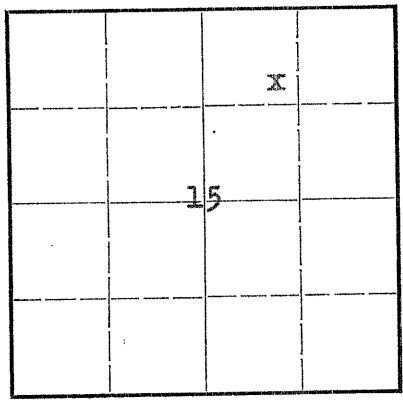

Locate well correctly on above Section Plat

CASING RECORD

Table with columns: Formation, Content, From, To, Size, Put In, Pulled Out. Row 1: Viola, oil-wtr., 3180', 3183', 16", 84', Left in hole. Row 2: 7", 3179', Rec. 2200'

Describe in detail the manner in which the well was plugged, indicating where the mud fluid was placed and the method or methods used in introducing it into the hold. If cement or other plugs were used, state the character of same and depth placed, from feet to feet for each plug set.

3183' To 3178' PB W/cement
3178' To 105' PB W/mud
105' To 93' PB W/cement
93' To 0' Capped W/15 Sax cement

(If additional description is necessary, use BACK of this sheet)

Correspondence regarding this well should be addressed to R. T. McNally, Sup't. Address: Box 650, McPherson, Kansas

STATE OF Kansas, COUNTY OF McPherson, ss. R. T. McNally (employee of owner) or (owner or operator) of the above-described well,

being first duly sworn on oath, says: That I have knowledge of the facts, statements, and matters herein contained and the log of the above-described well as filed and that the same are true and correct. So help me God.

(Signature) R. T. McNally Box 650, McPherson, Kansas (Address)

SUBSCRIBED AND SWORN to before me this 20th day of May 1947

My commission expires 9-14-1950.

PLUGGING FILE SEC 15 T 26 R 2E BOOK PAGE 104 LINE 20

Received 5/21/47 Noted Public.

WELL LOG

15-173-03473-00-00

WELL: P. F. Lygrisse "A" No. 10
LOC.: SE NW NE, Section 15-26S-2E

CASING RECORD

16" Cemented at 84' W/100 Sacks
7" Cemented at 3179' W/300 Sacks

0	70	Clay
	74	Lime
	82	Broken lime
	84	Lime
	135	Shale & shells
	352	Broken lime
	410	Lime
	783	Broken lime
	803	Shale & shells
	818	Lime
	880	Broken lime
	1007	Shale & shells
	1014	Lime
	1420	Shale & shells
	1441	Lime
	1477	Shale & shells
	1481	Shale
	1539	Lime
	1558	Broken lime
	1598	Shale
	1801	Shale & shells
	1815	Broken lime
	1834	Lime
	1856	Broken lime
	2080	Shale & shells
	2195	Broken lime
	2296	Lime
	2318	Broken lime
	2346	Lime
	2518	Broken lime
	2679	Lime
	2885	Shale & shells
	2895	Lime & chert
	2913	Shale & shells
	2922	Chat (Med. Hard)
	2938	Chat (Soft)
	2989	Chat (Hard)
	3029	Chat
	3067	Chat & lime
	3109	Lime
	3126	Shale
	3133	Lime
	3183	Lime - Total Depth

ELEVATION: 1396'
DISTRICT: Greenwich
COUNTY: Sedgwick
STATE: Kansas

PLUGGING
FILE SEC 15 T 26 R 2E
BOOK PAGE 104 LINE 20

APR - 1 1947