

RP


Give All Information Completely
Make Required Affidavit
Mail or Deliver Report to:
Conservation Division
State Corporation Commission
211 No. Broadway
Wichita, Kansas

WELL PLUGGING RECORD

Sedgwick County, Sec. 15 Twp. 26 Rge. 2 (E) (W)

Location as "NE/CNW/SW" or footage from lines NE S. 1/4 E.
Lease Owner Reading & Bates Offshore Drilling Co.
Lease Name Lygrisee P.F. Lygrisse A 144240 Well No. 9
Office Address 11th Floor Philtover Bldg., Tulsa, Oklahoma
Character of Well (completed as Oil, Gas or Dry Hole) oil well
Date well completed _____ 19____
Application for plugging filed _____ 19____
Application for plugging approved _____ 19____
Plugging commenced 7-9-65 _____ 19____
Plugging completed 7-12-65 _____ 19____
Reason for abandonment of well or producing formation depleted

NORTH

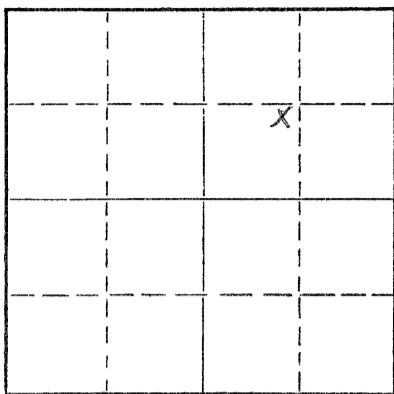

Locate well correctly on above Section Plat

If a producing well is abandoned, date of last production _____ 19____
Was permission obtained from the Conservation Division or its agents before plugging was commenced? yes

Name of Conservation Agent who supervised plugging of this well Paul Turpin
Producing formation _____ Depth to top _____ Bottom _____ Total Depth of Well 3188 Feet
Show depth and thickness of all water, oil and gas formations.

OIL, GAS OR WATER RECORDS

CASING RECORD

FORMATION	CONTENT	FROM	TO	SIZE	PUT IN	PULLED OUT
				7"	3160	2105.19

Describe in detail the manner in which the well was plugged, indicating where the mud fluid was placed and the method or methods used in introducing it into the hole. If cement or other plugs were used, state the character of same and depth placed, from _____ feet to _____ feet for each plug set.

Hole was filled up to 2123'. Mixed and dumped 5 sacks of cement at this point. Set 15' rock bridge from 2225' to 2110' and dump 30 sacks cement. Mud hole to 25' and dump 10 sacks cement.

RECEIVED
STATE CORPORATION COMMISSION
7/27/65
JUL 27 1965

CONSERVATION DIVISION
Wichita, Kansas

(If additional description is necessary, use BACK of this sheet)
Name of Plugging Contractor Flint Engineering & Construction Company
Address Box 950, El Dorado, Kansas

STATE OF KANSAS, COUNTY OF BUTLER, ss.

(employee of owner) or (owner or operator) of the above-described well, being first duly sworn on oath, says: That I have knowledge of the facts, statements, and matters herein contained and the log of the above-described well as filed and that the same are true and correct. So help me God.

(Signature) Paul Bawdle
El Dorado, Kansas
(Address)

SUBSCRIBED AND SWORN TO before me this 20th day of July, 1965

My commission expires 9-27-67
Notary Public.


KANSAS WELL LOG BUREAU - KANSAS GEOLOGICAL SOCIETY.
Union National Bank Bldg, Wichita, Kansas.

SHELL PETROLEUM CORP.
P.F. Jygrisse (No. A-9)

SEC. 15 T. 26 R. 2E.
NE SW NE
990' SL 990' WL

Total Depth. 3188
Comm. 12-22-34 Comp. 1-31-35,
Shot or Treated. 1000 gal acid.
Contractor. Olson Drilling Co.
Issued. 2-16-35.

County. Sedgwick.

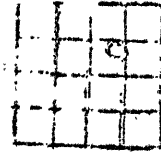

Placed

Rotary O to 3183
CASING. Cable 3183 to 3188

Elevation.

16" 95' 7" 3183"

Production Pumped 1235 B.O

Figures Indicate Bottom of Formations. & 290 B.W. 24 hours.

lime and shells	80
lime	150
broken lime	400
lime	425
broken lime	442
lime	470
broken lime	552
lime	600
broken lime	778
shale	816
broken lime	874
shale and shells	1239
shale and shells	1475
lime	1533
broken lime	1811
lime	1831
broken lime	1875
shale	1900
broken lime	1998
lime	2010
broken lime	2043
lime	2066
broken lime	2087
lime	2286
broken lime	2314
lime	2339
lime	2346
broken lime	2357
lime	2435
shale and shells	2477
lime	2586
lime	2609
S.L.M. 2604 equals 2609	
shale and shells	2770
broken lime	2798
shale	2846
V.C. shale	2900
S.L.M. 2898 equals 2900	
V.C. shale and broken lime	2907
V.C. shale	2917
chat hard & lime	2922
chat soft and lime	2926
chat hard and lime	2930
chat soft and lime	2941
chat hard and lime	2951
chat	3061

lime	3068
chat and lime	3077
lime	3112
shale	3130
lime	3134
shale and shells	3141
shale	3183
chalc. pep.	3186
dolomite lime	3188

T.D. 3187 200' of oil in 1/2 hr.
T.D. 3188 500' oil in 1 1/2 hrs.
Total Depth

1-27-35 swabbed 200 bbls oil and
15 bbls water in 12 hours.
1-30-35 swab 465 bbls oil and 20 bbls
water in 6 hours.

Handwritten calculations:
2917
- 1401

1516 chat
3186
- 1401

1785

RECEIVED
STATE CORPORATION COMMISSION
JUL 8 1935
CONSERVATION DIVISION
Wichita, Kansas