

15-173-00811-00-00

WELL PLUGGING RECORD

STATE OF KANSAS
STATE CORPORATION COMMISSION

Give All Information Completely
Make Required Affidavit
Mail or Deliver Report to:
Conservation Division
State Corporation Commission
800 Bittling Building
Wichita, Kansas

OR

FORMATION PLUGGING RECORD

Strike out upper line
when reporting plug-
ging of formations.

Sedgwick County. Sec. 15 Twp. 26S Rge. 2 (E) (X)

Location as "NE 1/4 NW 1/4 SW 1/4" or footage from lines 1080' WL: 870' SL SE 1/4

Lease Owner Shell Oil Company

Lease Name K. F. Fischer Well No. 10

Office Address Box 744, Great Bend, Kansas

Character of Well (completed as Oil, Gas or Dry Hole) Oil

Date well completed July 9, 1935

Application for plugging filed September 16, 1949

Application for plugging approved September 17, 1949


Plugging commenced December 18, 1949

Plugging completed December 23, 1949

Reason for abandonment of well or producing formation Depleted

If a producing well is abandoned, date of last production November 1948

Was permission obtained from the Conservation Division or its agents before plugging was commenced? Yes

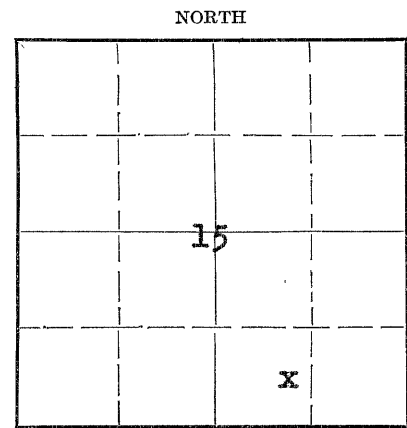

Locate well correctly on above
Section Plat

Name of Conservation Agent who supervised plugging of this well J. P. Roberts

Producing formation Viola limestone Depth to top 3202 Bottom 3204 Total Depth of Well 3204 Feet

Show depth and thickness of all water, oil and gas formations.

OIL, GAS OR WATER RECORDS

CASING RECORD

Formation	Content	From	To	Size	Put In	Pulled Out
Mississippi lime	water	2899	3108	13-3/8"	91'	none
Kinderhook shale	-	3108	3202	7"	3181'	2050'
Viola lime	oil & wtr.	3202	3204			

Describe in detail the manner in which the well was plugged, indicating where the mud fluid was placed and the method or methods used in introducing it into the hole. If cement or other plugs were used, state the character of same and depth placed, from...feet to...feet for each plug set.

From 3204 to 3185 Plugged back with sand.
3185 to 3150 " " " cement.
3150 to 160 " " " mud.
160 to 150 " " " rock.
150 to 15 " " " mud.
15 to 0 " " " cement.

RECEIVED
Conservation Div.
1/3/50
JAN 3 X 1950
STATE CORPORATION
COMMISSION
KANSAS

(If additional description is necessary, use BACK of this sheet)

Correspondence regarding this well should be addressed to S. S. Mabry, Superintendent, Shell Oil Co.
Address Box 744, Great Bend, Kansas

STATE OF Kansas, COUNTY OF Barton, ss.

O. C. Packey (employee of owner) or (owner or operator) of the above-described well, being first duly sworn on oath, says: That I have knowledge of the facts, statements, and matters herein contained and the log of the above-described well as filed and that the same are true and correct. So help me God.

(Signature) O. C. Packey

Box 744 Great Bend, Kansas (Address)

SUBSCRIBED AND SWORN to before me this 30th day of December, 1949.

My commission expires January 24, 1953.

22-2625 2-48-1511

Betty Postlethwaite
Notary Public.
PLUGGING
FILE SEC 15 T 26 R 2 E
BOOK PAGE 114 LINE 33

15-173-00811-00-00

WELL LOG
SHELL, K. F. FISCHER NO. 10
SE NE SW SE SECTION 15-26S-2E
1080' fr WL 870' fr SL
GREENWICH FIELD, SEDGWICK CO, KANSAS

Total Depth 3204
 Comm. 6-8-35 Comp. 7-9-35
 shot or Treated. 1000 gal acid.
 Contractor.
 Issued. 7-27-35.

Casing: 13-3/8" 91'
 7" 3181'

Production: 1016 B. 72 Hrs.
 Pumping

Figures Indicate Bottom of Formations.

soil	75	3150 equals 3154 S.L.C.	
lime shells	91	shale	3181
anhydrite	140	shell lime hard	3182
anhydrite & shale	197	standardizing.	
shale & shells	375	shale blk	3202
shale & lime	461	chert	3202' 2"
shale and shells	573	dolomite show of oil	3204 T.D.
lime and shale	745	hole filled up 860' of oil and	
lime	843	260' of water in 6 hours at 3204.	
shale and shells	1267		
shale and shells	1416	7-10-35. Swabbed 115 bbls. oil and	
lime	1442	65 bbls. water in 18 hours.	
shale and lime	1464		
lime	1478	7-13-35. Swabbed 445 bbls. oil and	
broken lime and shale	1525	460 bbls. water in 10 1/2 hours.	
shale	1540		
shale & lime shells	1638	339 B.O. and 1230 B.W. 3 day	
lime and shale	1766	average (pumping).	
shale and shells	1861		
lime and shale	1973		
shale & lime shells	2067		
lime	2136		
lime and shale	2264		
lime	2346		
lime	2394		
lime and shale	2431		
shale and shells	2497		
lime and shale	2607		
lime	2646		
broken lime	2750		
lime and shale	2841		
lime and shale	2882		
Var. ool shale	2899		
chat soft	2910		
chat hard	2913		
chat soft	2930		
chat soft	2934		
chat hard	2950		
chat	3002		
chat hard and sharp	3022		
lime	3031		
lime hard	3056		
lime	3089		
lime brown	3108		
shale	3150		

RECEIVED

PLUGGING
 FILE SEC 15 T. 26 S. 2 E
 BOOK PAGE 114 LINE 33