

15-173-20189-00-00


STATE OF KANSAS
STATE CORPORATION COMMISSION

WELL PLUGGING RECORD

Give All Information Completely
Make Required Affidavit
Mail or Deliver Report to
Conservation Division
State Corporation Comm.
245 North Water
Wichita, KS 67202

Sedgwick County. Sec. 15 Twp. 26S Rge. 2 E/WX
Location as "NE/CNW $\frac{1}{4}$ SW $\frac{1}{4}$ " or footage from lines
75' N of SW NE SE

Lease Owner United Petroleum Co.
Lease Name Fischer Well No. 3A KCC 244
Office Address 630 R.H.Garvey Bldg., Wichita, Ks. 67202
Character of Well (Completed as Oil, Gas or Dry Hole) dry hole

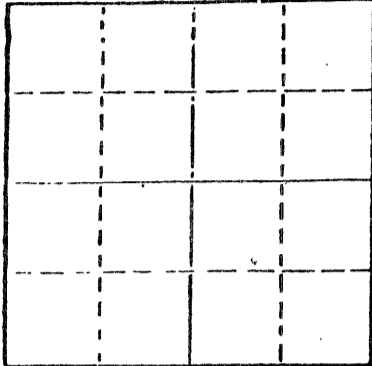

Locate well correctly on above
Section Plot

Date Well completed 8-28 1978
Application for plugging filed 8-28 1978
Application for plugging approved 8-28 1978
Plugging commenced 8-28 1978
Plugging completed 8-28 1978

Reason for abandonment of well or producing formation
no commercial quantities of oil or gas encountered

If a producing well is abandoned, date of last production
-- 19

Was permission obtained from the Conservation Division or
its agents before plugging was commenced? yes

Name of Conservation Agent who supervised plugging of this well Don Thompson
Producing formation _____ Depth to top _____ Bottom _____ Total Depth of Well 2912
Show depth and thickness of all water, oil and gas formations.

OIL, GAS OR WATER RECORDS

CASING RECORD

FORMATION	CONTENT	FROM	TO	SIZE	PUT IN	PULLED OUT
surface hole	shale	surf	205'	8-5/8"	203'	none

Describe in detail the manner in which the well was plugged, indicating where the mud fluid was placed and the method or methods used in introducing it into the hold. If cement or other plugs were used, state the character of same and depth placed, from _____ feet to _____ feet for each plug set.

RECEIVED
STATE CORPORATION COMMISSION
9/11/78
SEP 01 1978

Fluid to 200', plug, 25 sx
Fluid to 40', plug, 15 sx
3 sx in rat hole

CONSERVATION DIVISION
Wichita, Kansas

(If additional description is necessary, use BACK of this sheet)

Name of Plugging Contractor _____

STATE OF Kansas COUNTY OF Sedgwick, ss.
Ella Priess (employee of owner) or (owner or operator)
of the above-described well, being first duly sworn on oath, says: That I have knowledge of the facts, statements, and matters herein contained and the log of the above-described well as filed and that the same are true and correct. So help me God.

(Signature) Ella Priess
Suite 515 R.H.Garvey Bldg., Wichita, Ks. 67202
(Address)

SUBSCRIBED AND SWORN TO before me this 31st day of August, 19 78

My commission expires 4/30/79

Dorothy L. Schmidt
Dorothy L. Schmidt Notary Public.

DOROTHY L. SCHMIDT
STATE NOTARY PUBLIC
Sedgwick County, Kansas
My Appt. Exp. April 30, 1979

DRILLER'S LOG

UNITED PETROLEUM COMPANY
No. 3A Fischer
75' N of SW NE SE
Sec. 15-26S-2E
Sedgwick Co., Ks.

Commenced: 8-24-78
Completed: 8-29-78

Surface Casing: 203' of 8-5/8"
cemented w/150 sx common, 3% gel.
8-24-78

<u>FORMATION</u>	<u>DEPTH</u>
Surface Hole	0 - 205
Sand & Shale	205 - 1322
Shale & Sand	1322 - 1740
Sand & Shale	1740 - 2125
Shale & Lime	2125 - 2435
Shale, Sand & Lime	2435 - 2746
Shale & Lime	2746 - 2902
Lime	2902 - 2912 RTD

I do hereby certify that the foregoing statements are true and correct to the best of my knowledge and belief.

D N B DRILLING INC.
Ella Priess
Ella Priess

STATE OF KANSAS: ss:

Subscribed and sworn to before me this 31st day of August, 1978.

Dorothy L. Schmidt
Dorothy L. Schmidt

DOROTHY L. SCHMIDT
STATE NOTARY PUBLIC
Sedgwick County, Kansas
My Appt. Exp. April 30, 1979

RECEIVED
CORPORATION COMMISSION
SEP 01 1978
CONSERVATION DIVISION
Wichita, Kansas