


WELL PLUGGING RECORD

STATE OF KANSAS
STATE CORPORATION COMMISSION
Give All Information Completely
Make Required Affidavit
Mail or Deliver Report to:
Conservation Division
State Corporation Commission
800 Bitting Building
Wichita, Kansas

OR
FORMATION PLUGGING RECORD

Strike out upper line
when reporting plug-
ging of formations.

NORTH

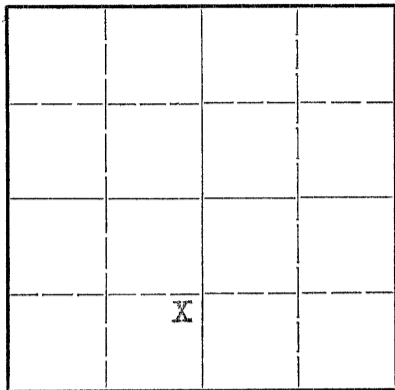

Locate well correctly on above
Section Plat

Sedgwick County. Sec. 15 Twp. 26S Rge. 2 (E) (W)
Location as "NE 1/4 NW 1/4 SW 1/4" or footage from lines. NE SE SW
Lease Owner SHELL OIL COMPANY, Inc.
Lease Name ~~W. Brown~~ Wm. Brown, Jr. Well No. 3
Office Address Box 650 McPherson, Kansas.
Character of Well (completed as Oil, Gas or Dry Hole) Oil Well
Date well completed Nov. 11 1929
Application for plugging filed 6-12- 1946
Application for plugging approved 6-14- 1946
Plugging commenced 7-22- 1946
Plugging completed 8- 8- 1946
Reason for abandonment of well or producing formation Well Depleted

If a producing well is abandoned, date of last production June 1945
Was permission obtained from the Conservation Division or its agents before plugging was com-
menced? Yes

Name of Conservation Agent who supervised plugging of this well Ruel Durkee
Producing formation Viola Depth to top 3202 Bottom 3205 Total Depth of Well 3205 Feet
Show depth and thickness of all water, oil and gas formations.

OIL, GAS OR WATER RECORDS


CASING RECORD

Formation	Content	From	To	Size	Put In	Pulled Out
Viola	Oil & Water	3202	3205	15-1/2"	88'	Left in Hole
				8-5/8"	2865'	Rec. 2228'
				7"	3193'	Rec. 2904'

Describe in detail the manner in which the well was plugged, indicating where the mud fluid was placed and the method or methods used in introducing it into the hole. If cement or other plugs were used, state the character of same and depth placed, from _____ feet to _____ feet for each plug set.

3205 to 3180 PB w/ cement
3180 to 110 PB w/ mud
110 to 90 PB w/rock
90 to 78 PB w/ cement
78 to base of cellar PB w/ mud
Capped into cellar with 5 sacks
of cement.

15 26 2E
58 40

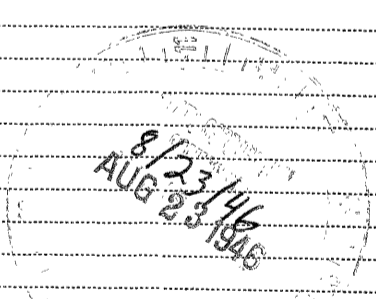

(If additional description is necessary, use BACK of this sheet)

Correspondence regarding this well should be addressed to R. T. McNally, Sup't. SHELL OIL CO. INC.
Address Box 650 McPherson, Kansas.

STATE OF Kansas, COUNTY OF McPherson, ss.
R. T. McNally, Sup't. (employee of owner) or (owner or operator) of the above-described well,
being first duly sworn on oath, says: That I have knowledge of the facts, statements, and matters herein contained and the log of the above-
described well as filed and that the same are true and correct. So help me God.

(Signature) R.T. McNally
Box 650, McPherson, Kansas.
(Address)

SUBSCRIBED AND SWORN to before me this 21 day of August 19 46

My commission expires Dec. 28th. 1946

J. S. White
Notary Public.

WELL: Wm. Brown No. 3

LOCATION: NE SE SW, SEC. 15-26S-2E

15 1/8" Cemented @ 88'
8-5/8" Cemented @2865'
7" Cemented @2888'
Set
*7" Cemented @3193'

*2888' of 7" & 305' of 6-5/8" LW

0 88 Surface
364 Shale-shells
552 Broken shale-lime
871 Shale-lime
1040 Shale
1441 Shale-lime shells
1591 Broken lime
1817 Shale-lime shells
1973 Broken lime-shale
1983 Broken lime
2101 Shale
2141 Broken lime
2211 Lime
2249 Broken lime
2279 Shale
2307 Broken lime
2426 Lime
2458 Broken lime
2489 Lime
2524 Broken lime
2565 Lime
2666 Shale-broken lime
2696 Broken lime
2734 Shale-shells
2762 Broken lime
2800 Shale
2871 Broken lime-shale
2876 Green,yellow shale
2879 Green,red shale
2881 Brown lime
2888 Yellow shale SLM 2888'
2889 Black lime-chat
2893 Chat TD

ELEVATION: 1411'
DISTRICT: Greenwich
COUNTY: Sedgwick
STATE: Kansas

COMPLETED: 11-1929.

DEEPEINED: 6-1932.

2910 Chat
2920 Chat
2940 Chat & lime
3002 Chat
3010 Lime
3040 Hard lime
3145 Lime
3202 Shale
3205 Chert & brown lime
3205 Lime TD

COMPLETED: 8-1932.

15 26 2E
58 40