


15-173-03596-00-00

STATE OF KANSAS  
STATE CORPORATION COMMISSION

WELL PLUGGING RECORD

Give All Information Completely  
Make Required Affidavit  
Mail or Deliver Report to:  
Conservation Division  
State Corporation Commission  
800 Bittling Building  
Wichita, Kansas

Sedgwick County. Sec. 15 Twp. 26 Rge. 2 (E) XXXX  
Location as "NE/CNW $\frac{1}{4}$ SW $\frac{1}{4}$ " or footage from lines 1/2 SW NW 1/4 SW SE NW RCC  
Lease Owner W. R. Justice 2140  
Lease Name Lygrisse Well No. 3  
Office Address 519 So. Broadway, Wichita, Kansas  
Character of Well (completed as Oil, Gas or Dry Hole) Oil (Depleted)  
Date well completed 2/20/50 19 50  
Application for plugging filed September 19 50  
Application for plugging approved Sept. 28, 19 50  
Plugging commenced October 1, 19 50  
Plugging completed October 7, 19 50  
Reason for abandonment of well or producing formation Well depleted.

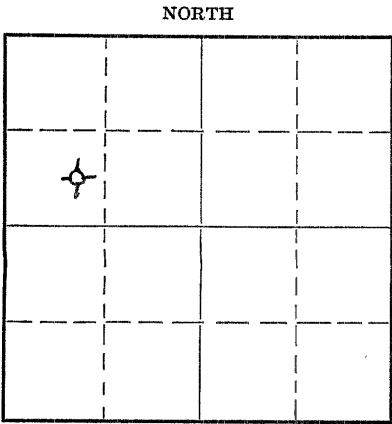

Locate well correctly on above  
Section Flat

If a producing well is abandoned, date of last production July 19 50  
Was permission obtained from the Conservation Division or its agents before plugging was commenced? Yes

Name of Conservation Agent who supervised plugging of this well D. C. Lilley  
Producing formation Mississippi Depth to top 2869 Bottom 2872 Total Depth of Well 2872 Feet  
Show depth and thickness of all water, oil and gas formations.

OIL, GAS OR WATER RECORDS

CASING RECORD

Formation	Content	From	To	Size	Put In	Pulled Out

Describe in detail the manner in which the well was plugged, indicating where the mud fluid was placed and the method or methods used in introducing it into the hole. If cement or other plugs were used, state the character of same and depth placed, from \_\_\_\_\_ feet to \_\_\_\_\_ feet for each plug set.

3 sax of cement on bottom, filled with mud to 150 feet; 12 sax cement on 10 foot rock bridge; filled to 10 feet of top with mud, capped surfact pipe with 5 sax of cement.

RECEIVED  
STATE CORPORATION COMMISSION  
10/12/50  
OCT 12 1950  
CONSERVATION DIVISION  
Wichita, Kansas

(If additional description is necessary, use BACK of this sheet)

Correspondence regarding this well should be addressed to W. R. Justice  
Address 519 S. Broadway, Wichita, Kansas

STATE OF Kansas, COUNTY OF Sedgwick, ss.  
W. D. Angle (employee of owner or operator) of the above-described well,  
being first duly sworn on oath, says: That I have knowledge of the facts, statements, and matters herein contained and the log of the above-described well as filed and that the same are true and correct. So help me God.

(Signature) W. D. Angle  
519 S. Broadway, Wichita, Kansas  
(Address)

SUBSCRIBED AND SWORN TO before me this 10th day of Oct, 19 50  
Christy Miller  
Notary Public.

My commission expires Feb. 3, 1954

FILE SEC 15 T 26 R 7E  
BOOK PAGE 31 LINE 17

DRILLING LOG

15-173-03596-00-00

WELL NAME: Lygrisse #3-A  
Owners: W. R. Justice et al.  
Contractors: Laura Jane Oil Co., Inc.  
Comm: 2/11/50  
Comp: 2/16/50 Rotary Depth  
2/20/50 Cable Depth

LOCATION: 1300' from E line 525' from  
S line NW/4 15-26S-2E Sedg.  
CASING RECORD: 5/8 @ 95'  
PRODUCTION: 20 BOPD

Formation	to	Remarks
Surface	175	
Lime	470	
Lime-shale	780	
Shale-shells	1510	
Shale-lime	1830	
Shale-shells	2045	
Lime-Shale	2300	
Shale	2420	
Lime	2630	
Lime-shale	2867	
Chat	2869 TD Rotary	
Cable Depth	2872	

I certify that the above is a true and correct copy of the log of the Lygrisse 3-A, 1300' from E line, 525' from S line NW4, 15-26S-2E, Sedgwick County, to the best of my knowledge.

LAURA JANE OIL CO., INC.,

BY: **RECEIVED**  
H. DAVIS CORPORATION, COMMISSION

SEP 29 1950

Sworn and subscribed to before me this 29th day of March, 1950.

Wichita, Kansas

NOTARY PUBLIC

My Comm. Expires 6/28/52

**PLUGGING**  
LINE 15, 26, 2E  
DATE MAR 31 1950