


15-065-00295-00-00

STATE OF KANSAS
STATE CORPORATION COMMISSION

Give All Information Completely
Make Required Affidavit
Mail or Deliver Report to:
Conservation Division
State Corporation Commission
800 Bittig Building
Wichita, Kansas

WELL PLUGGING RECORD

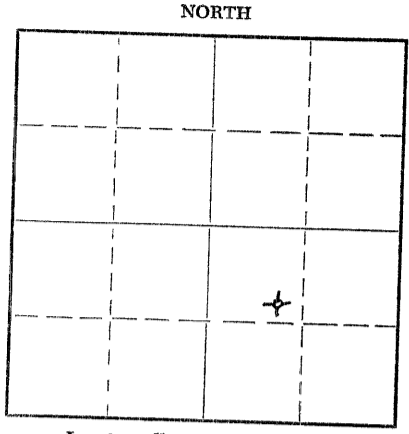

Locate well correctly on above
Section Plat

Graham County. Sec. 21 Twp. 38 Rge. 23 (E) W (W)
Location as "NE/CNW/SW" or footage from lines 990' WL 1200' NL of SE/4
Lease Owner Peel-Hardman Oil Producers
Lease Name Legere
Office Address P.O. Box 359 Hoisington, Kansas Well No. 2
Character of Well (completed as Oil, Gas or Dry Hole)
Date well completed 9-30 19 52
Application for plugging filed 11-7 19 52
Application for plugging approved 11-14 19 52
Plugging commenced 12-8 19 52
Plugging completed 12-18 19 52
Reason for abandonment of well or producing formation Dry Hole

If a producing well is abandoned, date of last production 19
Was permission obtained from the Conservation Division or its agents before plugging was commenced? Yes

Name of Conservation Agent who supervised plugging of this well Eldon Petty
Producing formation Depth to top Bottom Total Depth of Well 3797 Feet
Show depth and thickness of all water, oil and gas formations.

OIL, GAS OR WATER RECORDS

CASING RECORD

FORMATION	CONTENT	FROM	TO	SIZE	PUT IN	PULLED OUT
		0	210'	8 5/8"	210	None
		0	3791'	5 1/2"	3791'	3068.20'

Describe in detail the manner in which the well was plugged, indicating where the mud fluid was placed and the method or methods used in introducing it into the hole. If cement or other plugs were used, state the character of same and depth placed, from feet to feet for each plug set.

- 3797' - 214' - Heavy Rotary Mud
- 214' - 212' - Rock Bridge
- 212' - 166' - 15 sacks cement
- 166' - 35' - Heavy Rotary Mud
- 35' - 33' - Rock Bridge
- 33' - 6' - 10 sacks cement
- 6' - Surface - Cellar

Name of Plugging Contractor Bert Self
Address Hutchinson, Kansas
(If additional description is necessary, use BACK of this sheet)

STATE OF Kansas COUNTY OF Barton ss.
William Herbert (employee of owner) or (owner or operator) of the above-described well, being first duly sworn on oath, says: That I have knowledge of the facts, statements, and matters herein contained and the log of the above-described well as filed and that the same are true and correct. So help me God.

(Signature) By: *William Herbert*
P. O. Box 359 Hoisington, Kansas
(Address)

SUBSCRIBED AND SWORN TO before me this 13th day of February, 19 53

My commission expires June 4, 1955
Marion M. Herbert
Notary Public.

PLUGGING
FILE SEC 21 Twp 38 R 23
BOOK PAGE 57 LINE 30

2-16-53

15-065-00295-00-00

DRILLER'S LOG

Company: Peel-Hardman Oil Producers

Farm: Legere Well No. 2
Total Depth: 3795'

Comm: 9-6-52 Comp: 9-15-52
Contractor: Glenn W. Peel
Casing:

8 5/8" 210' cem.
5 1/2" 3791' cem.

990' WL 1200' NL of SE/4
Sec. 21, Twp. 8S, Rge. 23W

County: Graham, Kansas

Elevation:

Production: Dry

Figures below indicate bottom of formations

Surface Soil	0 -	210
Shale		725
Sand & Shale		1890
Red Bed & Shale		1945
Anhydrite		1990
Shale & Shells		2340
Lime & Shale		2520
Lime		2665
Lime & Shale		3415
Lime		3795
Total Depth		3795

This is to certify that the above information is, to the best of our knowledge true and correct.

GLENN W. PEEL

BY: Wm. Herbert 1952.

SUBSCRIBED AND SWORN to before me this 16th day of November

My commission expires June 4, 1955
Maria M. Herbert
Notary Public

Moved in cable tools Sept. 24, 1952, drilled cement and deepened hole to 3797', acidized with 500 gals. tested, ran Gamma Ray Log and perforated with 36 shots from 3786' to 3794', acidized with 1500 gals., swabbed hole down; 9-27-52 tested, perforated with 36 shots from 3771' to 3778' acidized with 1000 gals., 9-28-52 bailed and tested, set plug from 3767' to 3771', perforated with 24 shots from 3754' to 3762', test approx. 3 gals. oil per hr.; 9-29-52 acidized with 500 gals., swabbing, bailed and tested, perforated from 3740' to 3746' with 18 shots and from 3717' to 3730' with 37 shots acidized with 2000 gals. bailed 2 1/2 bals. oil and 8 gals. water per hr., tested further on 9-30-52, no commercial show of oil, tore down cable tools and moved out.

PLUGGING
WELL NO. 21 8 2324
DATE 57 JAN 30

11-7-52